


IT IS SEVERLY FORBIDDEN BY LAW TO COPY OR COMMUNICATE TO A THIRD PERSON THE CONTENTS OF PRESENT DRAWING

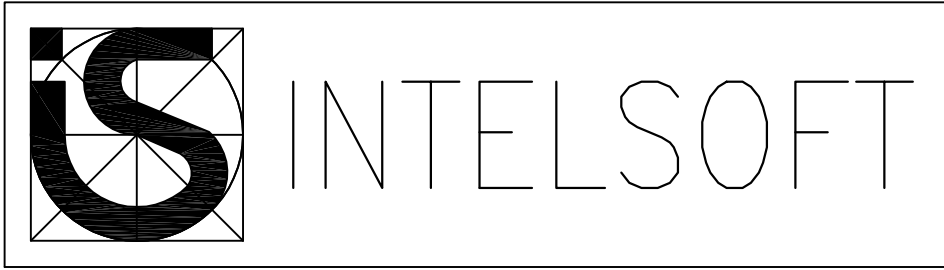

NOTE ASBUILT

PLANT LOCATION	ASCC ALEXANDRIA
SECTION	COVER PAGE
DOC. TYPE	MAERZ – CABINET LAYOUT

CLIENT

ASCC




JOB	ID7854			
DWG N.	ASCC_MRZ-2102			
FILE NAME	ASCC_MRZ-2102-001			
DATE	REV	PREV	PAGE	NEXT
30/05/2022	00	1/1	01	02

IT IS SEVERLY FORBIDDEN BY LAW TO COPY OR COMMUNICATE TO A THIRD PERSON THE CONTENTS OF PRESENT DRAWING



	0	1	2	3	4	5	6	7	8
A									
B									
C									
D									
E									
F									

Sheet	Description	REVISION				
		0	1	2	3	4
1	COVER	X				
2	INDEX 1/2	X				
3	INDEX 2/2	X				
4						
5						
6	BILL OF MATERIALS	X				
7						
8						
9						
10						
11						
12	PLC CABINET INTERNAL LAYOUT	X				
13	POWER SUPPLY	X				
14						
15	RACK 01 – POWER SUPPLY 24V CONNECTIONS	X				
16	RACK 02 – POWER SUPPLY 24V CONNECTIONS	X				
17	RACK 03 – POWER SUPPLY 24V CONNECTIONS	X				
18	RACK 04 – POWER SUPPLY 24V CONNECTIONS	X				
19						
20	DIGITAL INPUT MODULE TYPICAL WIRING	X				
21	DIGITAL OUTPUT MODULE TYPICAL WIRING	X				
22	ANALOG INPUT MODULE TYPICAL WIRING	X				
23	ANALOG OUTPUT MODULE TYPICAL WIRING	X				
24						
25						

 

Sheet	Description	REVISION				
		0	1	2	3	4
26	DI01 – WIRING DIAGRAM DIGITAL INPUT	X				
27	DI02 – WIRING DIAGRAM DIGITAL INPUT	X				
28	DI03 – WIRING DIAGRAM DIGITAL INPUT	X				
29	DI04 – WIRING DIAGRAM DIGITAL INPUT	X				
30	DI05 – WIRING DIAGRAM DIGITAL INPUT	X				
31	DI06 – WIRING DIAGRAM DIGITAL INPUT	X				
32	DI07 – WIRING DIAGRAM DIGITAL INPUT	X				
33	DI08 – WIRING DIAGRAM DIGITAL INPUT	X				
34	DI09 – WIRING DIAGRAM DIGITAL INPUT	X				
35	DI10 – WIRING DIAGRAM DIGITAL INPUT	X				
36	DI11 – WIRING DIAGRAM DIGITAL INPUT	X				
37	DI12 – WIRING DIAGRAM DIGITAL INPUT	X				
38	DI13 – WIRING DIAGRAM DIGITAL INPUT	X				
39						
40						
41						
42						
43	DO01 – WIRING DIAGRAM DIGITAL OUTPUT	X				
44	DO02 – WIRING DIAGRAM DIGITAL OUTPUT	X				
45	DO03 – WIRING DIAGRAM DIGITAL OUTPUT	X				
46	DO04 – WIRING DIAGRAM DIGITAL OUTPUT	X				
47	DO05 – WIRING DIAGRAM DIGITAL OUTPUT	X				
48	DO06 – WIRING DIAGRAM DIGITAL OUTPUT	X				
49	DO07 – WIRING DIAGRAM DIGITAL OUTPUT	X				
50	DO08 – WIRING DIAGRAM DIGITAL OUTPUT	X				

 	PLANT LOCATION	ASCC ALEXANDRIA	CLIENT 	JOB ID7854				
	SECTION	INDEX 1/2		DWG N. ASCC_MRZ-2102				
	DOC. TYPE	MAERZ - CABINET LAYOUT		FILE NAME ASCC_MRZ-2102-002				
NOTE ASBUILT				DATE	REV	PREV	PAGE	NEXT
				30/5/2022	02	01	02	03

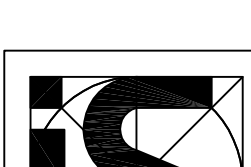[illegible]

 INTEL SOFT <small>NOTE</small> ASBUILT	 OriSoft Process Automation	PLANT LOCATION	ASCC ALEXANDRIA	CLIENT <div>ASCC</div>	JOB	ID7854			
		SECTION	INDEX 2/2		DWG. N.	ASCC_MRZ-2102			
		DOC. TYPE	MAERZ – CABINET LAYOUT		FILE NAME	ASCC_MRZ-2102-003			
					DATE	REV	PREV	PAGE	NE

IT IS SEVERLY FORBIDDEN BY LAW TO COPY OR COMMUNICATE TO A THIRD PERSON THE CONTENTS OF PRESENT DRAWING	A	0	1	2	3	4	5	6	7	8
		B	ITEM	Qty	PART ID	DESCRIPTION				
			1	4	6ES7390-1AF30-0AA0	SIMATIC S7-300, MOUNTING RAIL L=530MM				
			2							
	C		3	4	6ES7307-1KA01-0AA0	SIMATIC S7-300 POWER SUPPLY PS 307, 120/230 V AC; 24 V DC, 10A				
		4								
		5	1	6ES7315-2AG10-0AB0	SIMATIC S7-300 CPU 315-2DP, 128KBYTE RAM					
		6	1	6ES7953-8LG11-0AA0	SIMATIC S7, MICRO MEMORY CARD FOR S7-300, 128 KBYTES					
	D	7								
		8	1	6GK7343-1CX00-0XE0	SIMATIC NET, CP 343-1 LEAN COMMUNICATIONS PROCESSOR FOR ETHERNET					
		9								
		10	3	6ES7153-1AA03-0XB0	SIMATIC DP, ET 200M PERIPHERAL SYSTEM, S7-300 UNIT					
	E	11								
		12	4	6ES7331-7KF02-0AB0	SIMATIC S7-300, ANALOG INPUT UNIT SM 331, 8 CHANNELS					
		13	1	6ES7332-5HF00-0AB0	SIMATIC S7-300 ANALOG OUTPUT UNIT SM 332 , 8 CHANNELS					
		14	13	6ES7321-1BL00-0AA0	SIMATIC S7-300, DIGITAL INPUT UNIT SM 321, WITH VOLTAGE SEPARATION 32DI, DC 24V (1 X 32 DI)					
	F	15	9	6ES7322-1BL00-0AA0	SIMATIC S7-300, DIGITAL OUTPUT UNIT SM 322, WITH VOLTAGE SEPARATION 32DO, DC 24V, 0,5A TOTAL CURRENT 8A					
		16								
		17	22	6ES7392-1AM00-0AA0	SIMATIC S7-300, 40 PIN MODULE FRONT CONNECTOR					
		18	5	6ES7392-1AJ00-0AA0	SIMATIC S7-300, 20 PIN MODULE FRONT CONNECTOR					
		19								
		20	4	6ES7972-0BA41-0XA0	SIMATIC DP, PROFIBUS CONNECTOR					
		21								
		22								
		23								
		24	2	//	MOUNTING PLATE 620X520mm (REPLACEMENT OF OLD PLATES)					
		25								
		26	1	DES-100D	D-LINK 10/100 FAST ETHERNET SWITCH					
		27								
		28								
<div><div>INTELSOFT</div><div>OriSoft Process Automation</div></div>		PLANT LOCATION	ASCC ALEXANDRIA	CLIENT	<div>ASCC</div>	JOB					ID7854
NOTE	ASBUILT	SECTION	BILL OF MATERIALS			DWG. N.					ASCC_MRZ-2102
		DOC. TYPE	MAERZ – CABINET LAYOUT			FILE NAME					ASCC_MRZ-2102-006
				DATE		REV	PREV	PAGE	NE		
				30/05/2020		00	07	00	10		

IT IS SEVERLY FORBIDDEN BY LAW TO COPY OR COMMUNICATE TO A THIRD PERSON THE CONTENTS OF PRESENT DRAWING



NOTE ASBUILT

PLANT LOCATION ASCC ALEXANDRIA

SECTION PLC CABINET INTERNAL LAYOUT

DOC. TYPE MAERZ PLC CABINET LAYOUT

CLIENT

ASCC

JOB		ID7854			
DWG N.		ASCC_MRZ-2102			
FILE NAME		ASCC_MRZ-2102-012			
DATE	REV	PREV	PAGE	NEX	
05/14/2008	00	00	10	11	

IT IS SEVERLY FORBIDDEN BY LAW TO COPY OR COMMUNICATE TO A THIRD PERSON THE CONTENTS OF PRESENT DRAWING

A



B

C

D

E

F

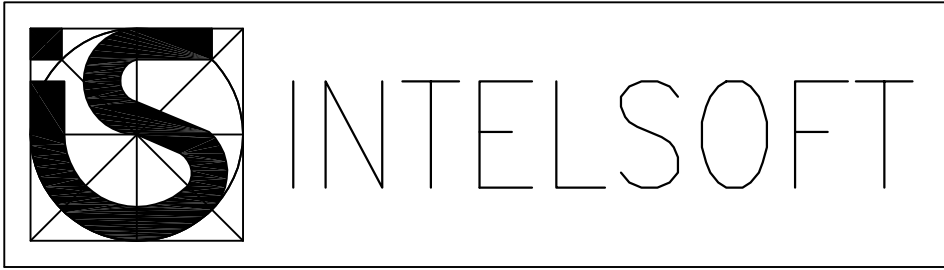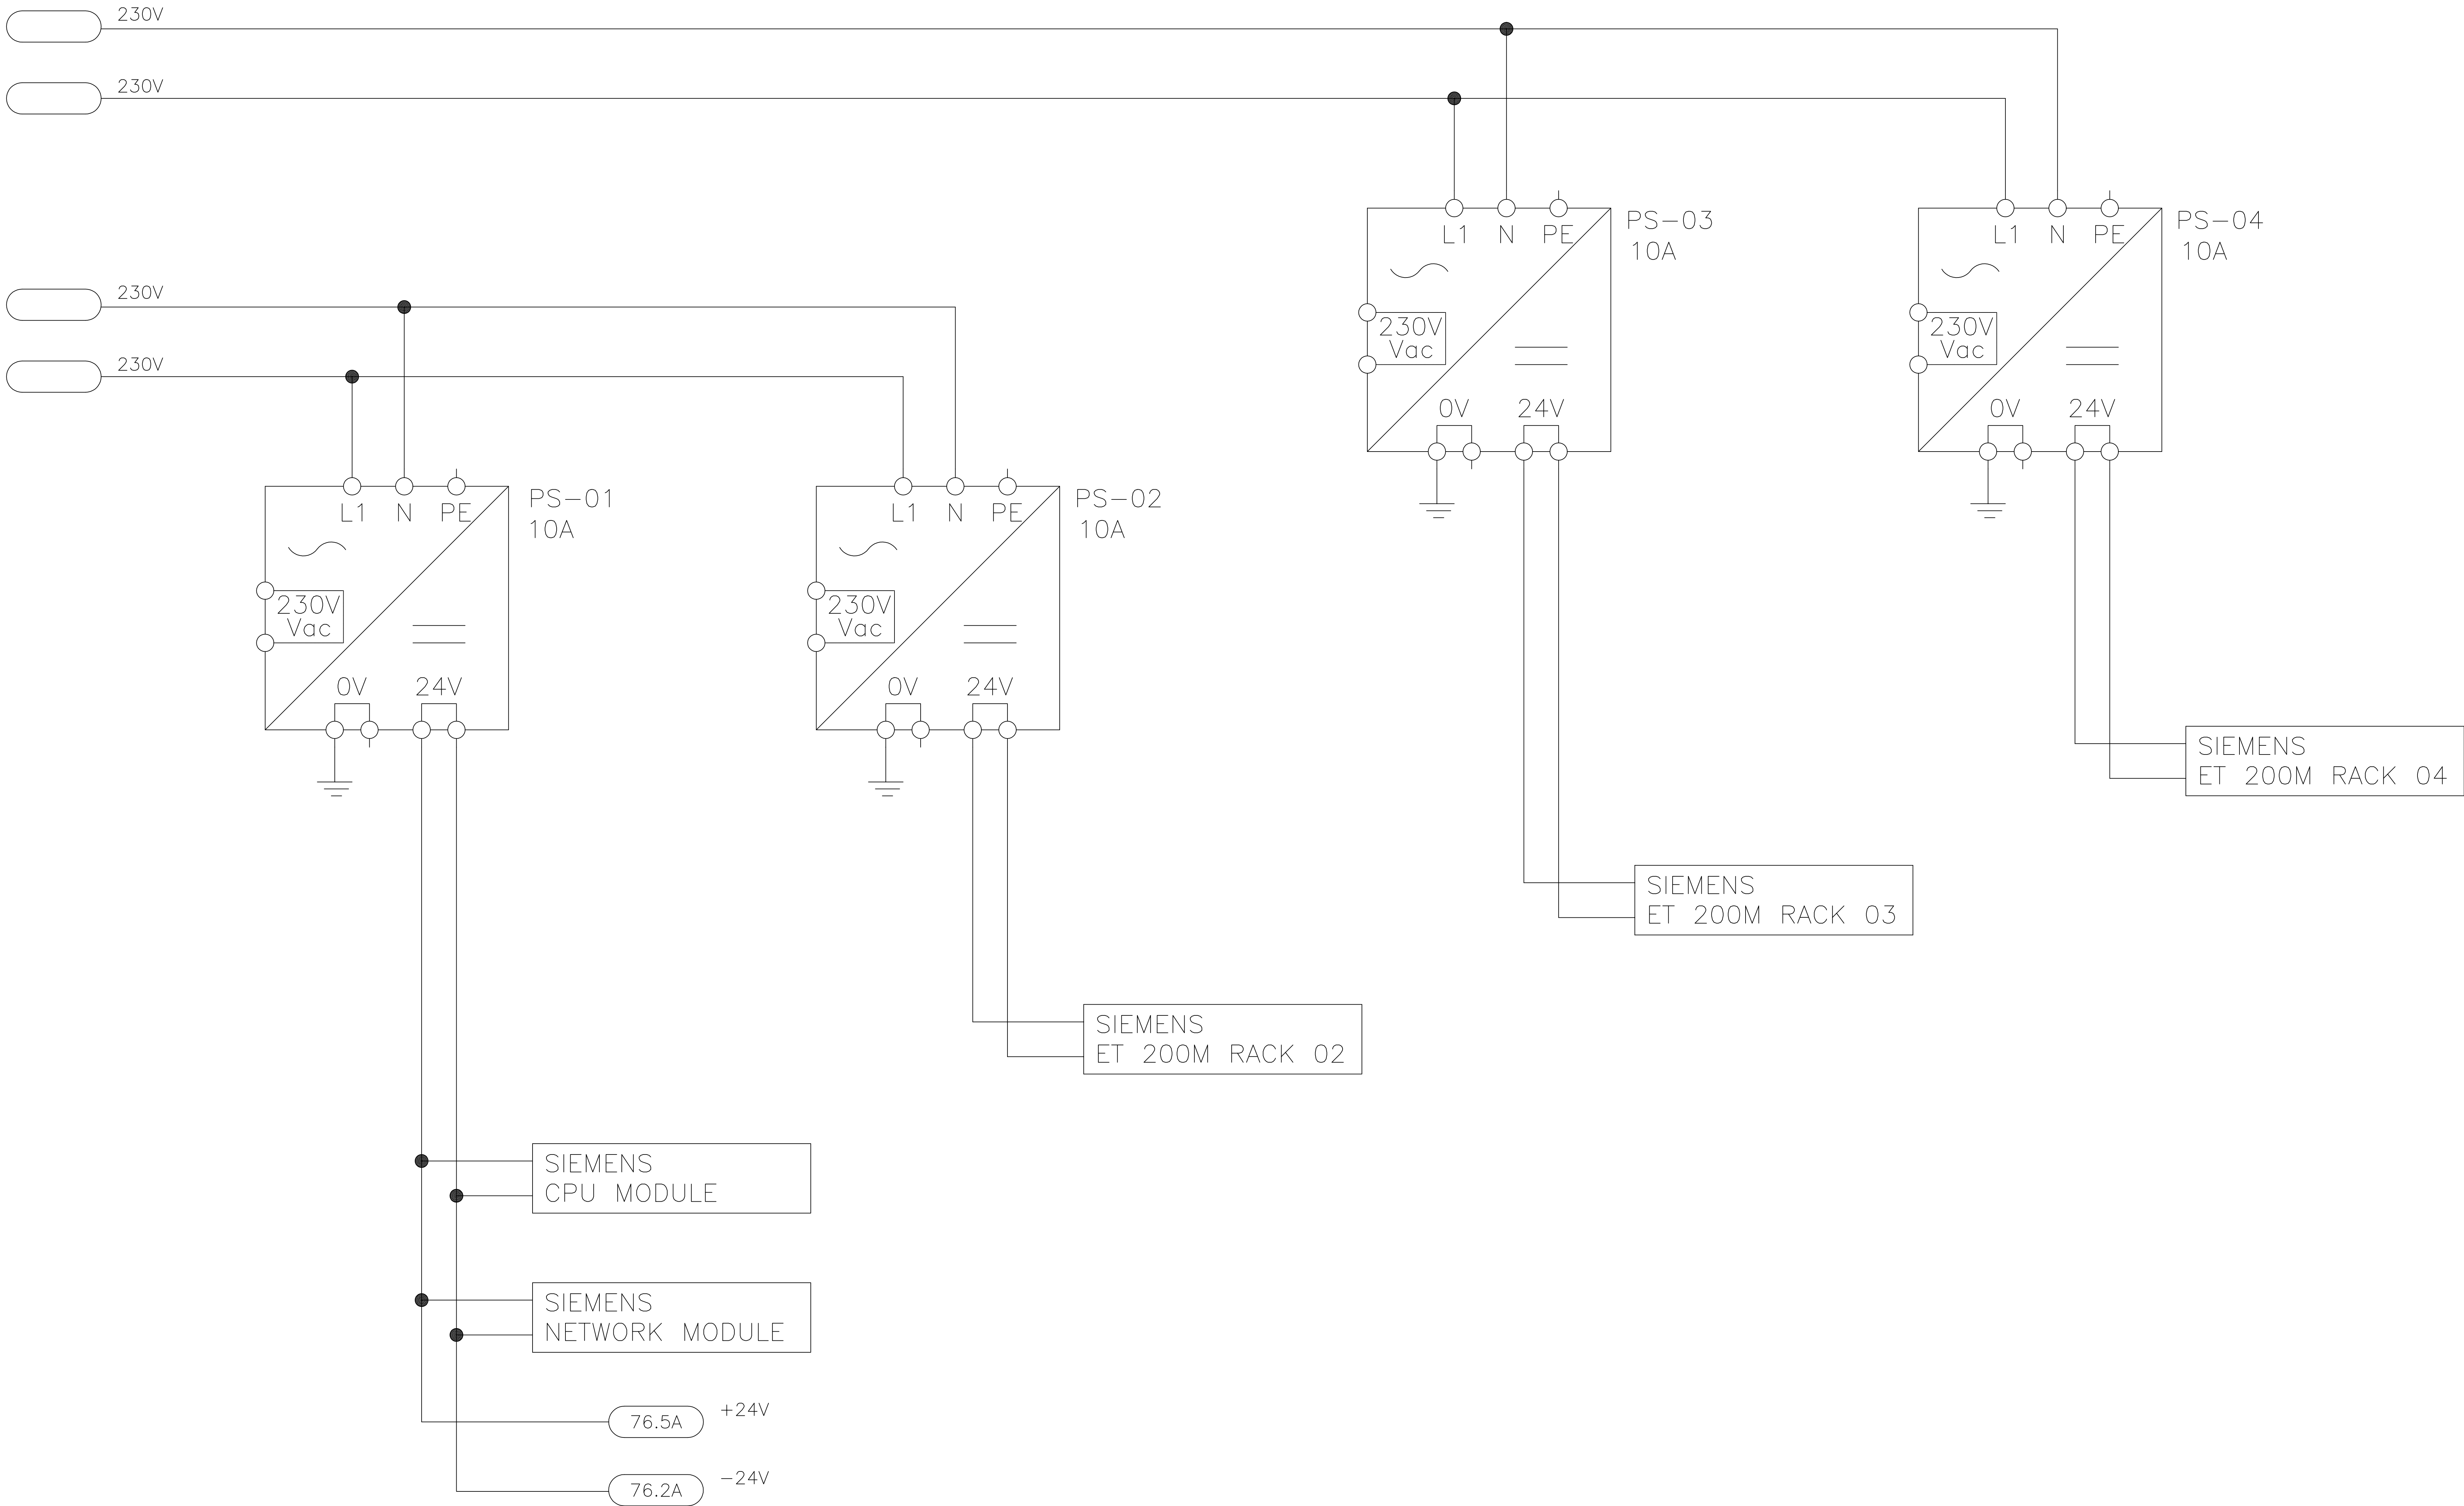

PLANT LOCATION ASCC ALEXANDRIA

SECTION POWER SUPPLYS


DOC. TYPE MAERZ – CABINET LAYOUT

CLIENT

ASCC

JOB	ID7854				
DWG N.	ASCC_MRZ-2102				
FILE NAME	ASCC_MRZ-2102-013				
DATE	REV	PREV	PAGE	NEX	
30/05/2000	00	10	13	15	

NOTE ASBUILT

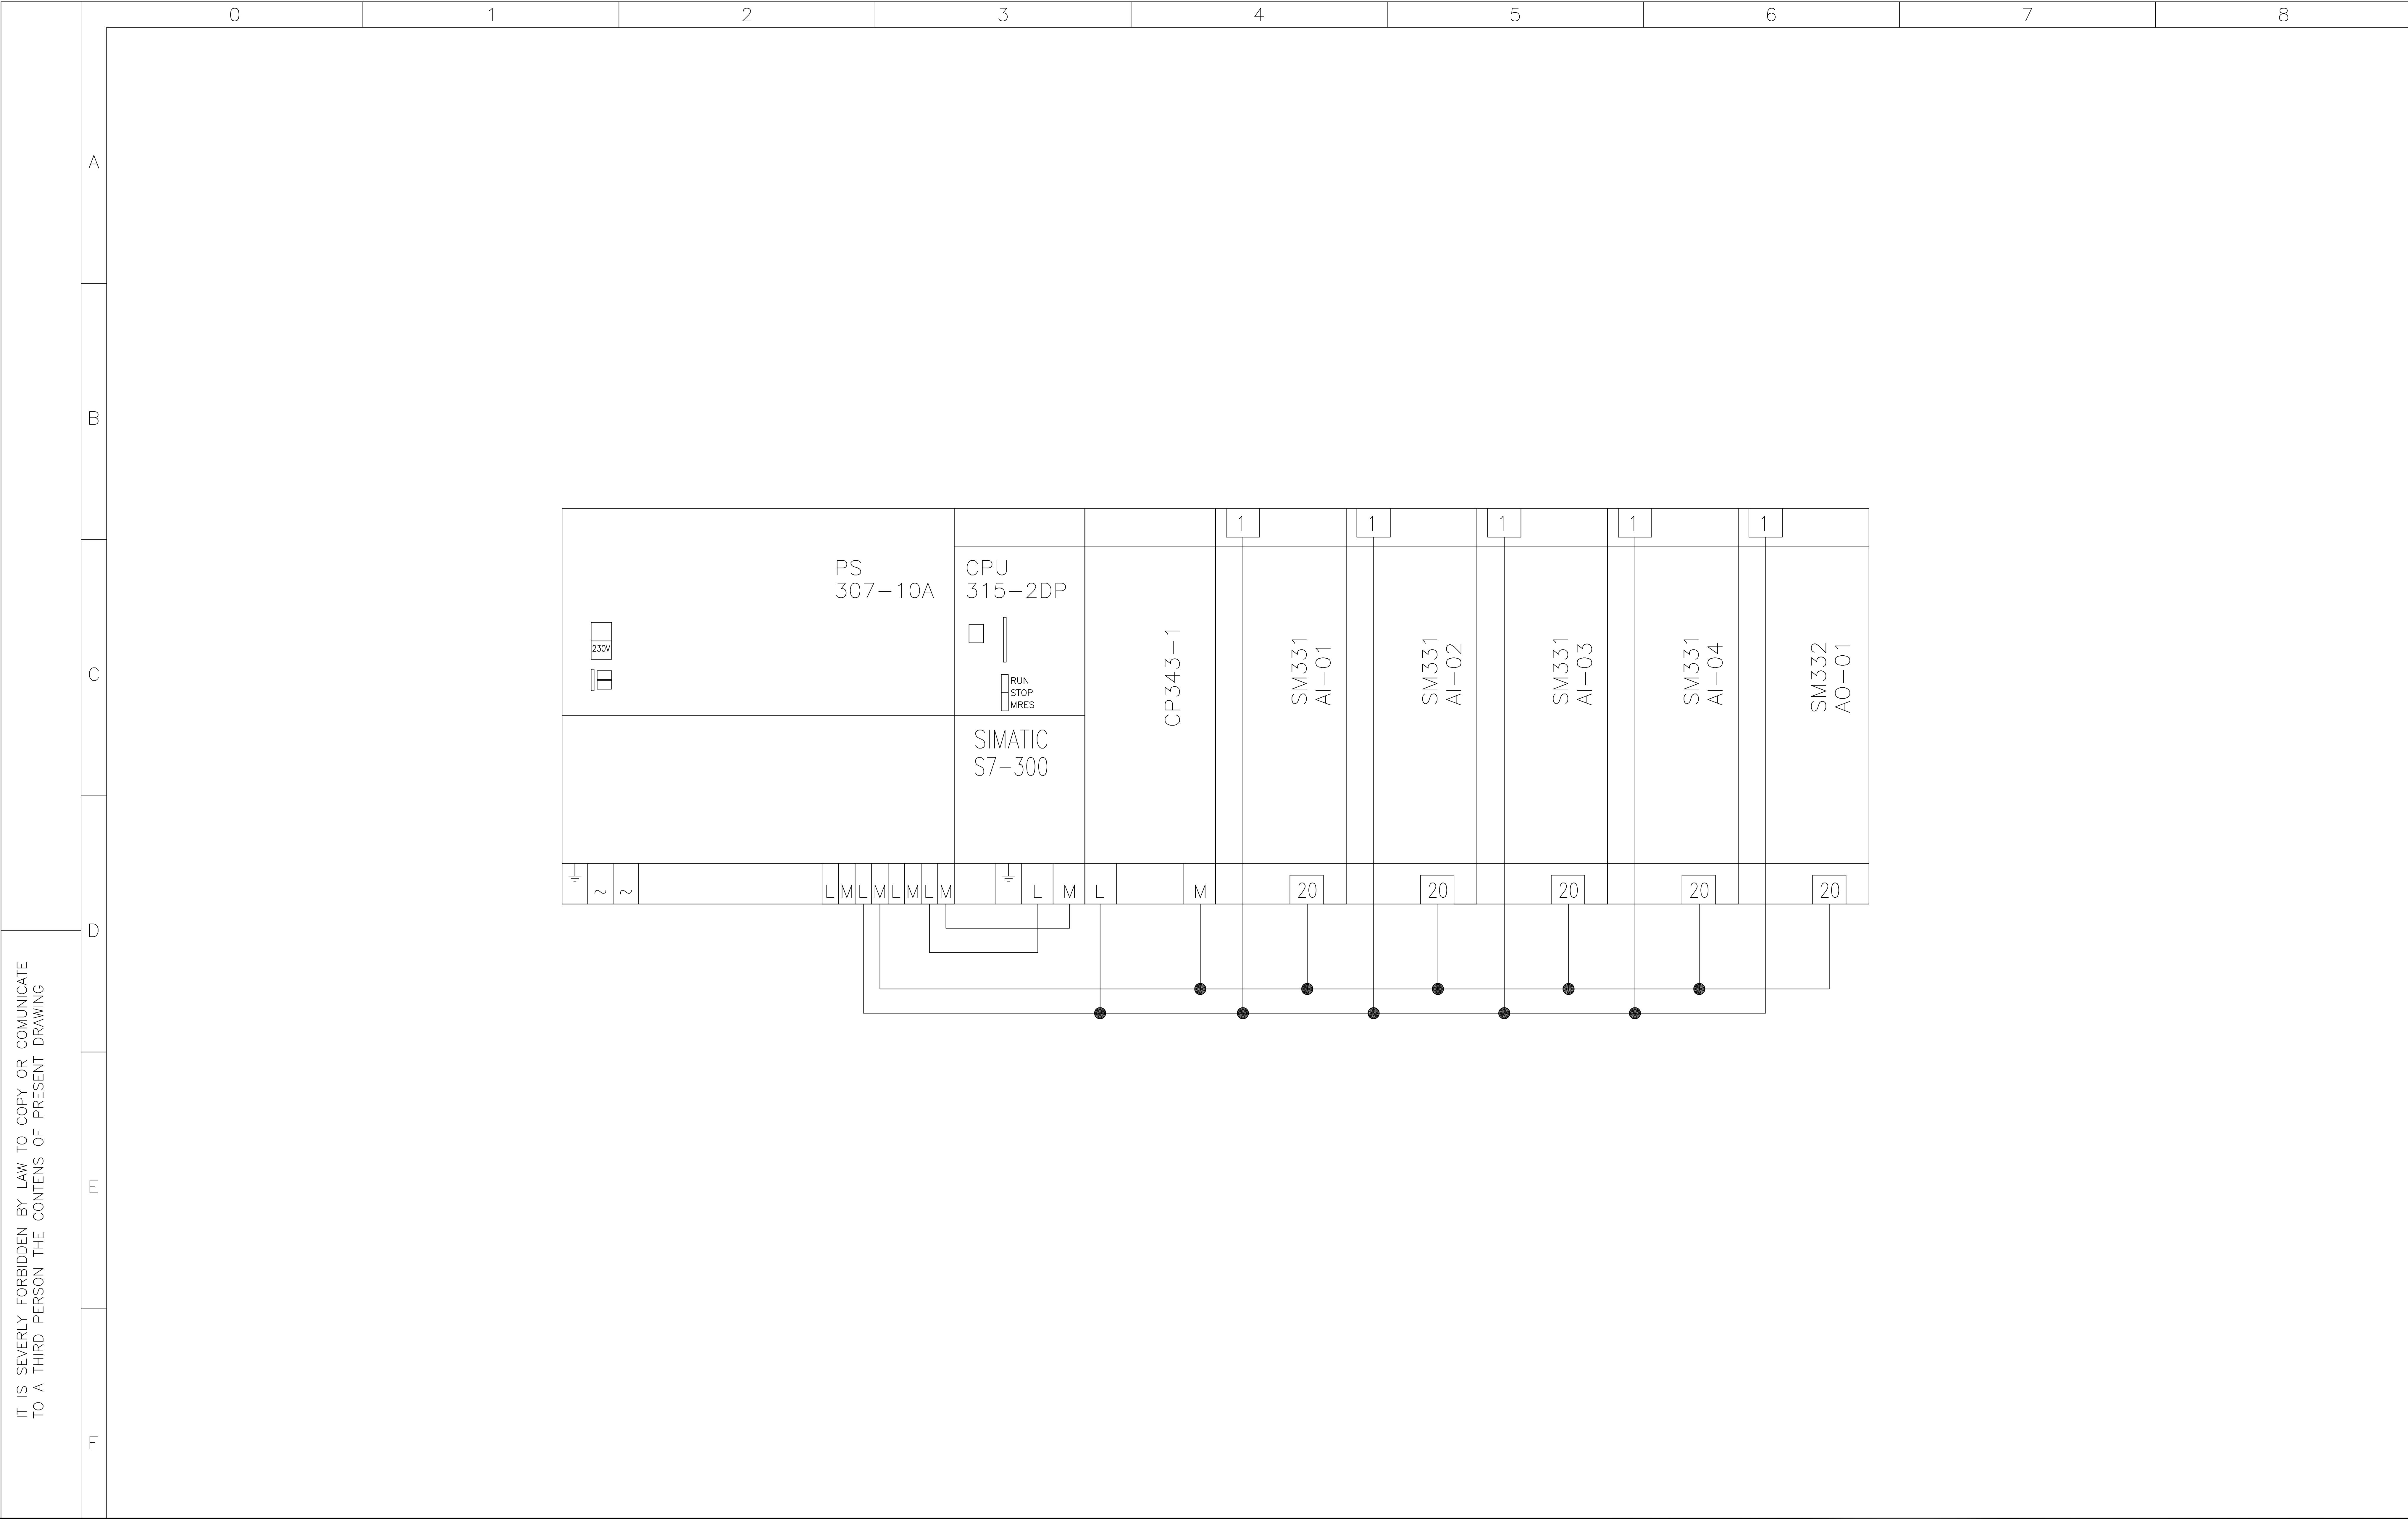



PLANT LOCATION	ASCC ALEXANDRIA
SECTION	RACK 01 – POWER SUPPLY 24V CONNECTIONS
DOC. TYPE	MAERZ – CABINET LAYOUT


ASCC



JOB		ID7854		
DWG. N.		ASCC_MRZ-2102		
FILE NAME		ASCC_MRZ-2102-015		
DATE	REV	PREV	PAGE	NEW

 


 	PLANT LOCATION	ASCC ALEXANDRIA	CLIENT <div>ASCC</div>	JOB					ID7854									
	SECTION	RACK 02 – POWER SUPPLY 24V		DWG N.					ASCC_MRZ-2102									
	DOC. TYPE	MAERZ – CABINET LAYOUT		FILE NAME					ASCC_MRZ-2102-016									
NOTE	ASBUILT			<table border="1"> <thead> <tr> <th>DATE</th> <th>REV</th> <th>PREV</th> <th>PAGE</th> <th>NE</th> </tr> </thead> <tbody> <tr> <td>30/5/2026</td> <td>00</td> <td>15</td> <td>16</td> <td></td> </tr> </tbody> </table>					DATE	REV	PREV	PAGE	NE	30/5/2026	00	15	16	
DATE	REV	PREV	PAGE	NE														
30/5/2026	00	15	16															

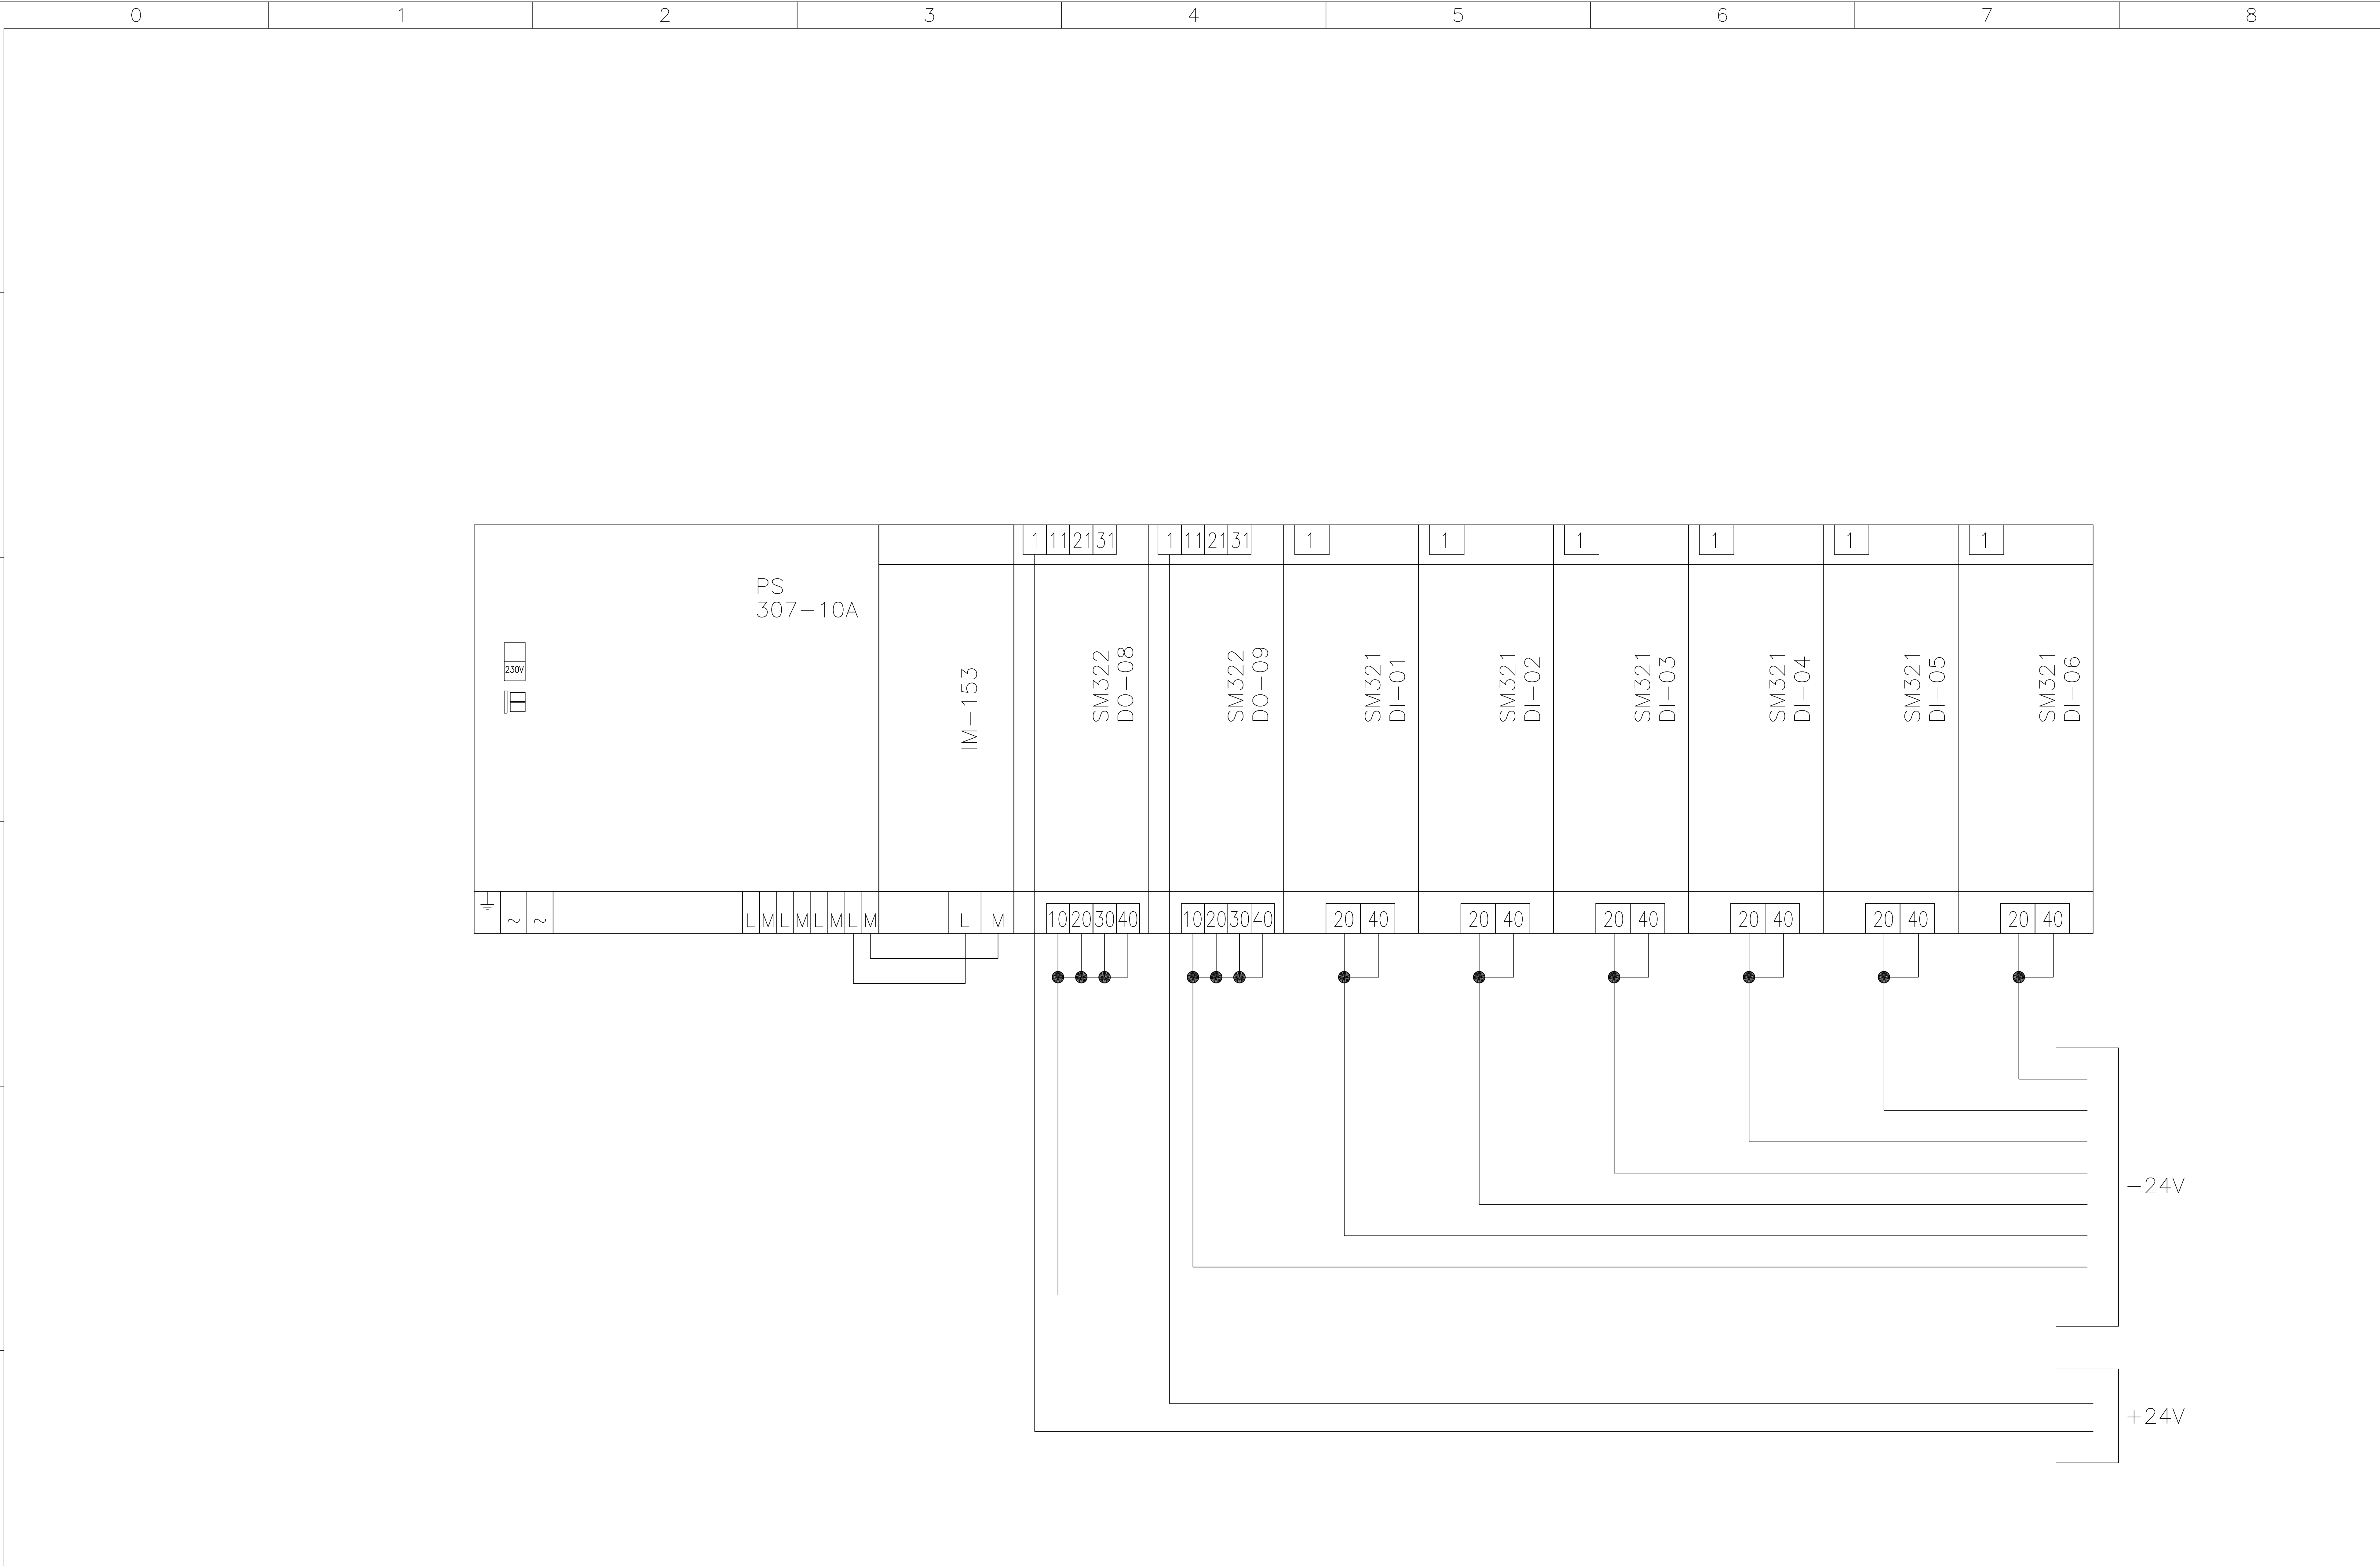IT IS SEVERLY FORBIDDEN BY LAW TO COPY OR COMMUNICATE TO A THIRD PERSON THE CONTENTS OF PRESENT DRAWING						
	F	E	D	C	B	A



 	PLANT LOCATION	ASCC ALEXANDRIA	<div>CLIENT</div> <div>ASCC</div>	JOB ID7854												
	SECTION	RACK 03 – POWER SUPPLY 24V		DWG. N. ASCC_MRZ-2102												
	DOC. TYPE	MAERZ – CABINET LAYOUT		FILE NAME ASCC_MRZ-2102-017												
	NOTE	ASBUILT		<table border="1"> <thead> <tr> <th>DATE</th> <th>REV</th> <th>PREV</th> <th>PAGE</th> <th>NE</th> </tr> </thead> <tbody> <tr> <td>30/5/2020</td> <td>00</td> <td>16</td> <td>17</td> <td></td> </tr> </tbody> </table>					DATE	REV	PREV	PAGE	NE	30/5/2020	00	16
DATE	REV	PREV	PAGE	NE												
30/5/2020	00	16	17													

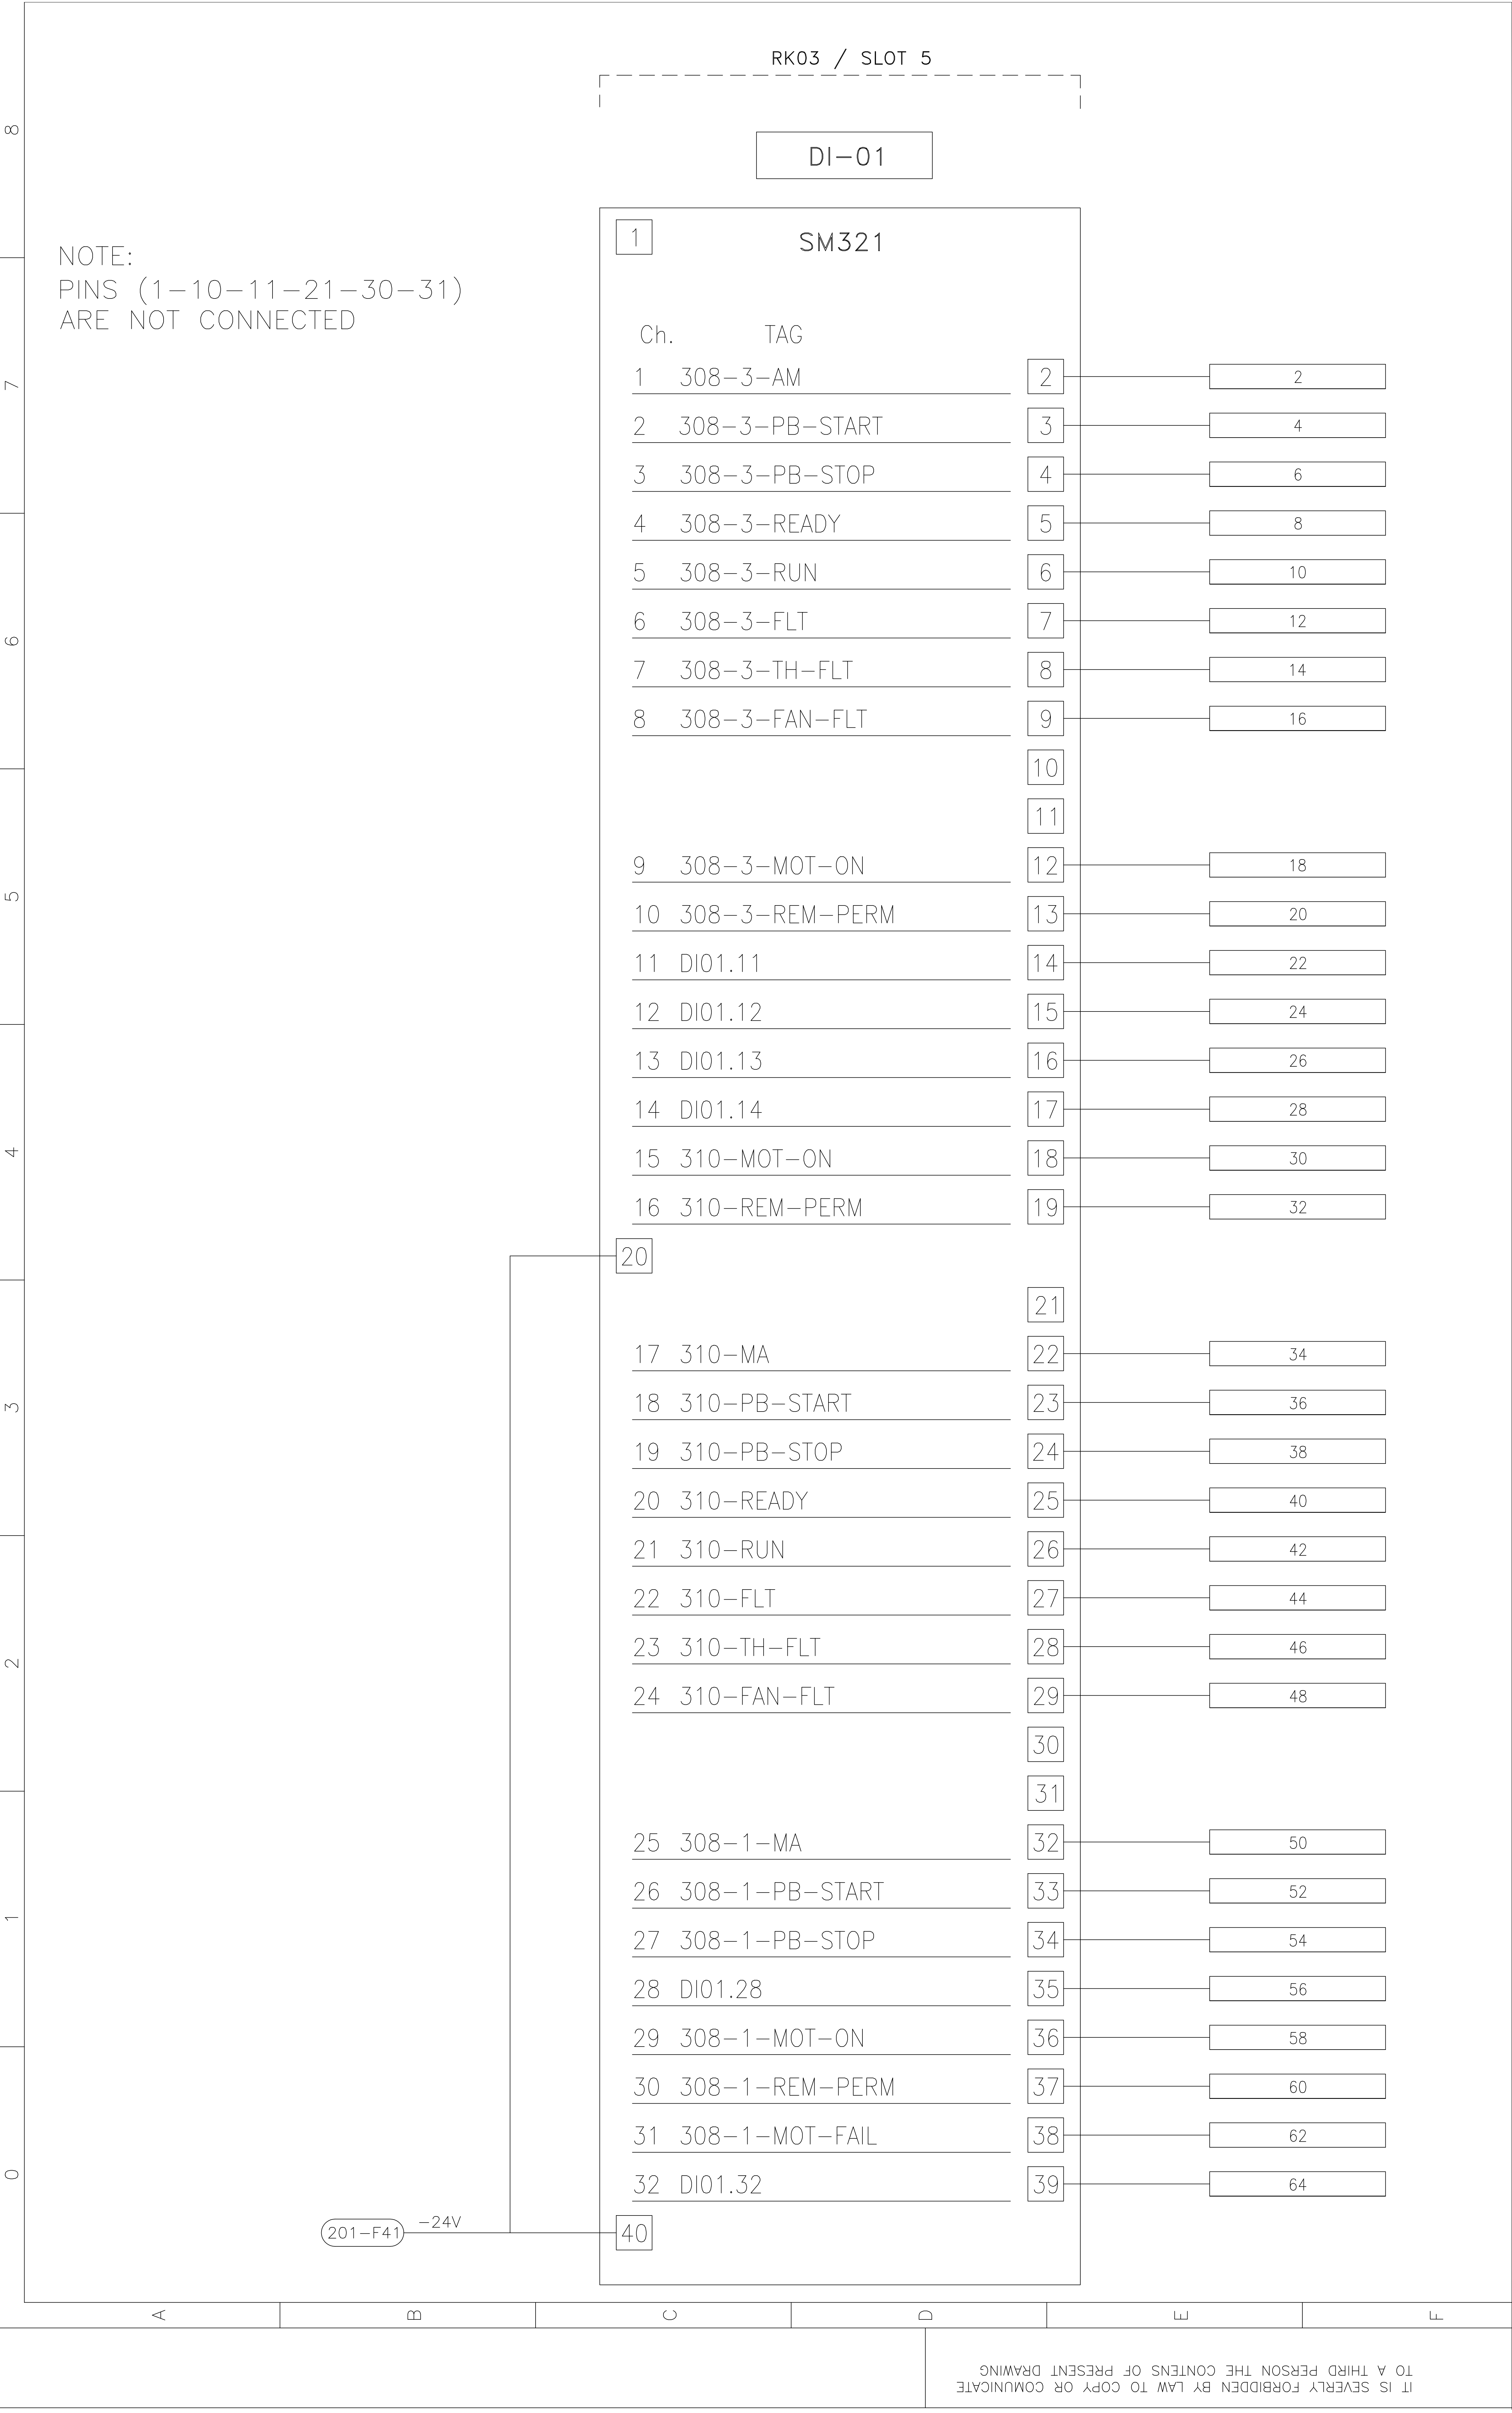

201-F41

-24V

40

32

31

30

29

308-1-MOT-FAIL

308-1-REM-PERM

308-1-MOT-ON

DIO1.28

308-1-PB-STOP

308-1-PB-START

308-1-MA

25

24

310-FAN-FLT

310-TH-FLT

310-FLT

310-RUN

310-READY

310-PB-STOP

310-PB-START

310-MA

17

21

20

310-REM-PERM

310-MOT-ON

DIO1.14

DIO1.13

DIO1.12

DIO1.11

308-3-REM-PERM

308-3-MOT-ON

10

9

8

308-3-FAN-FLT

308-3-TH-FLT

308-3-FLT

308-3-RUN

308-3-READY

308-3-PB-STOP

308-3-PB-START

308-3-AM

1

Ch.


TAG

SM321

1

DI-01

RK03 / SLOT 5

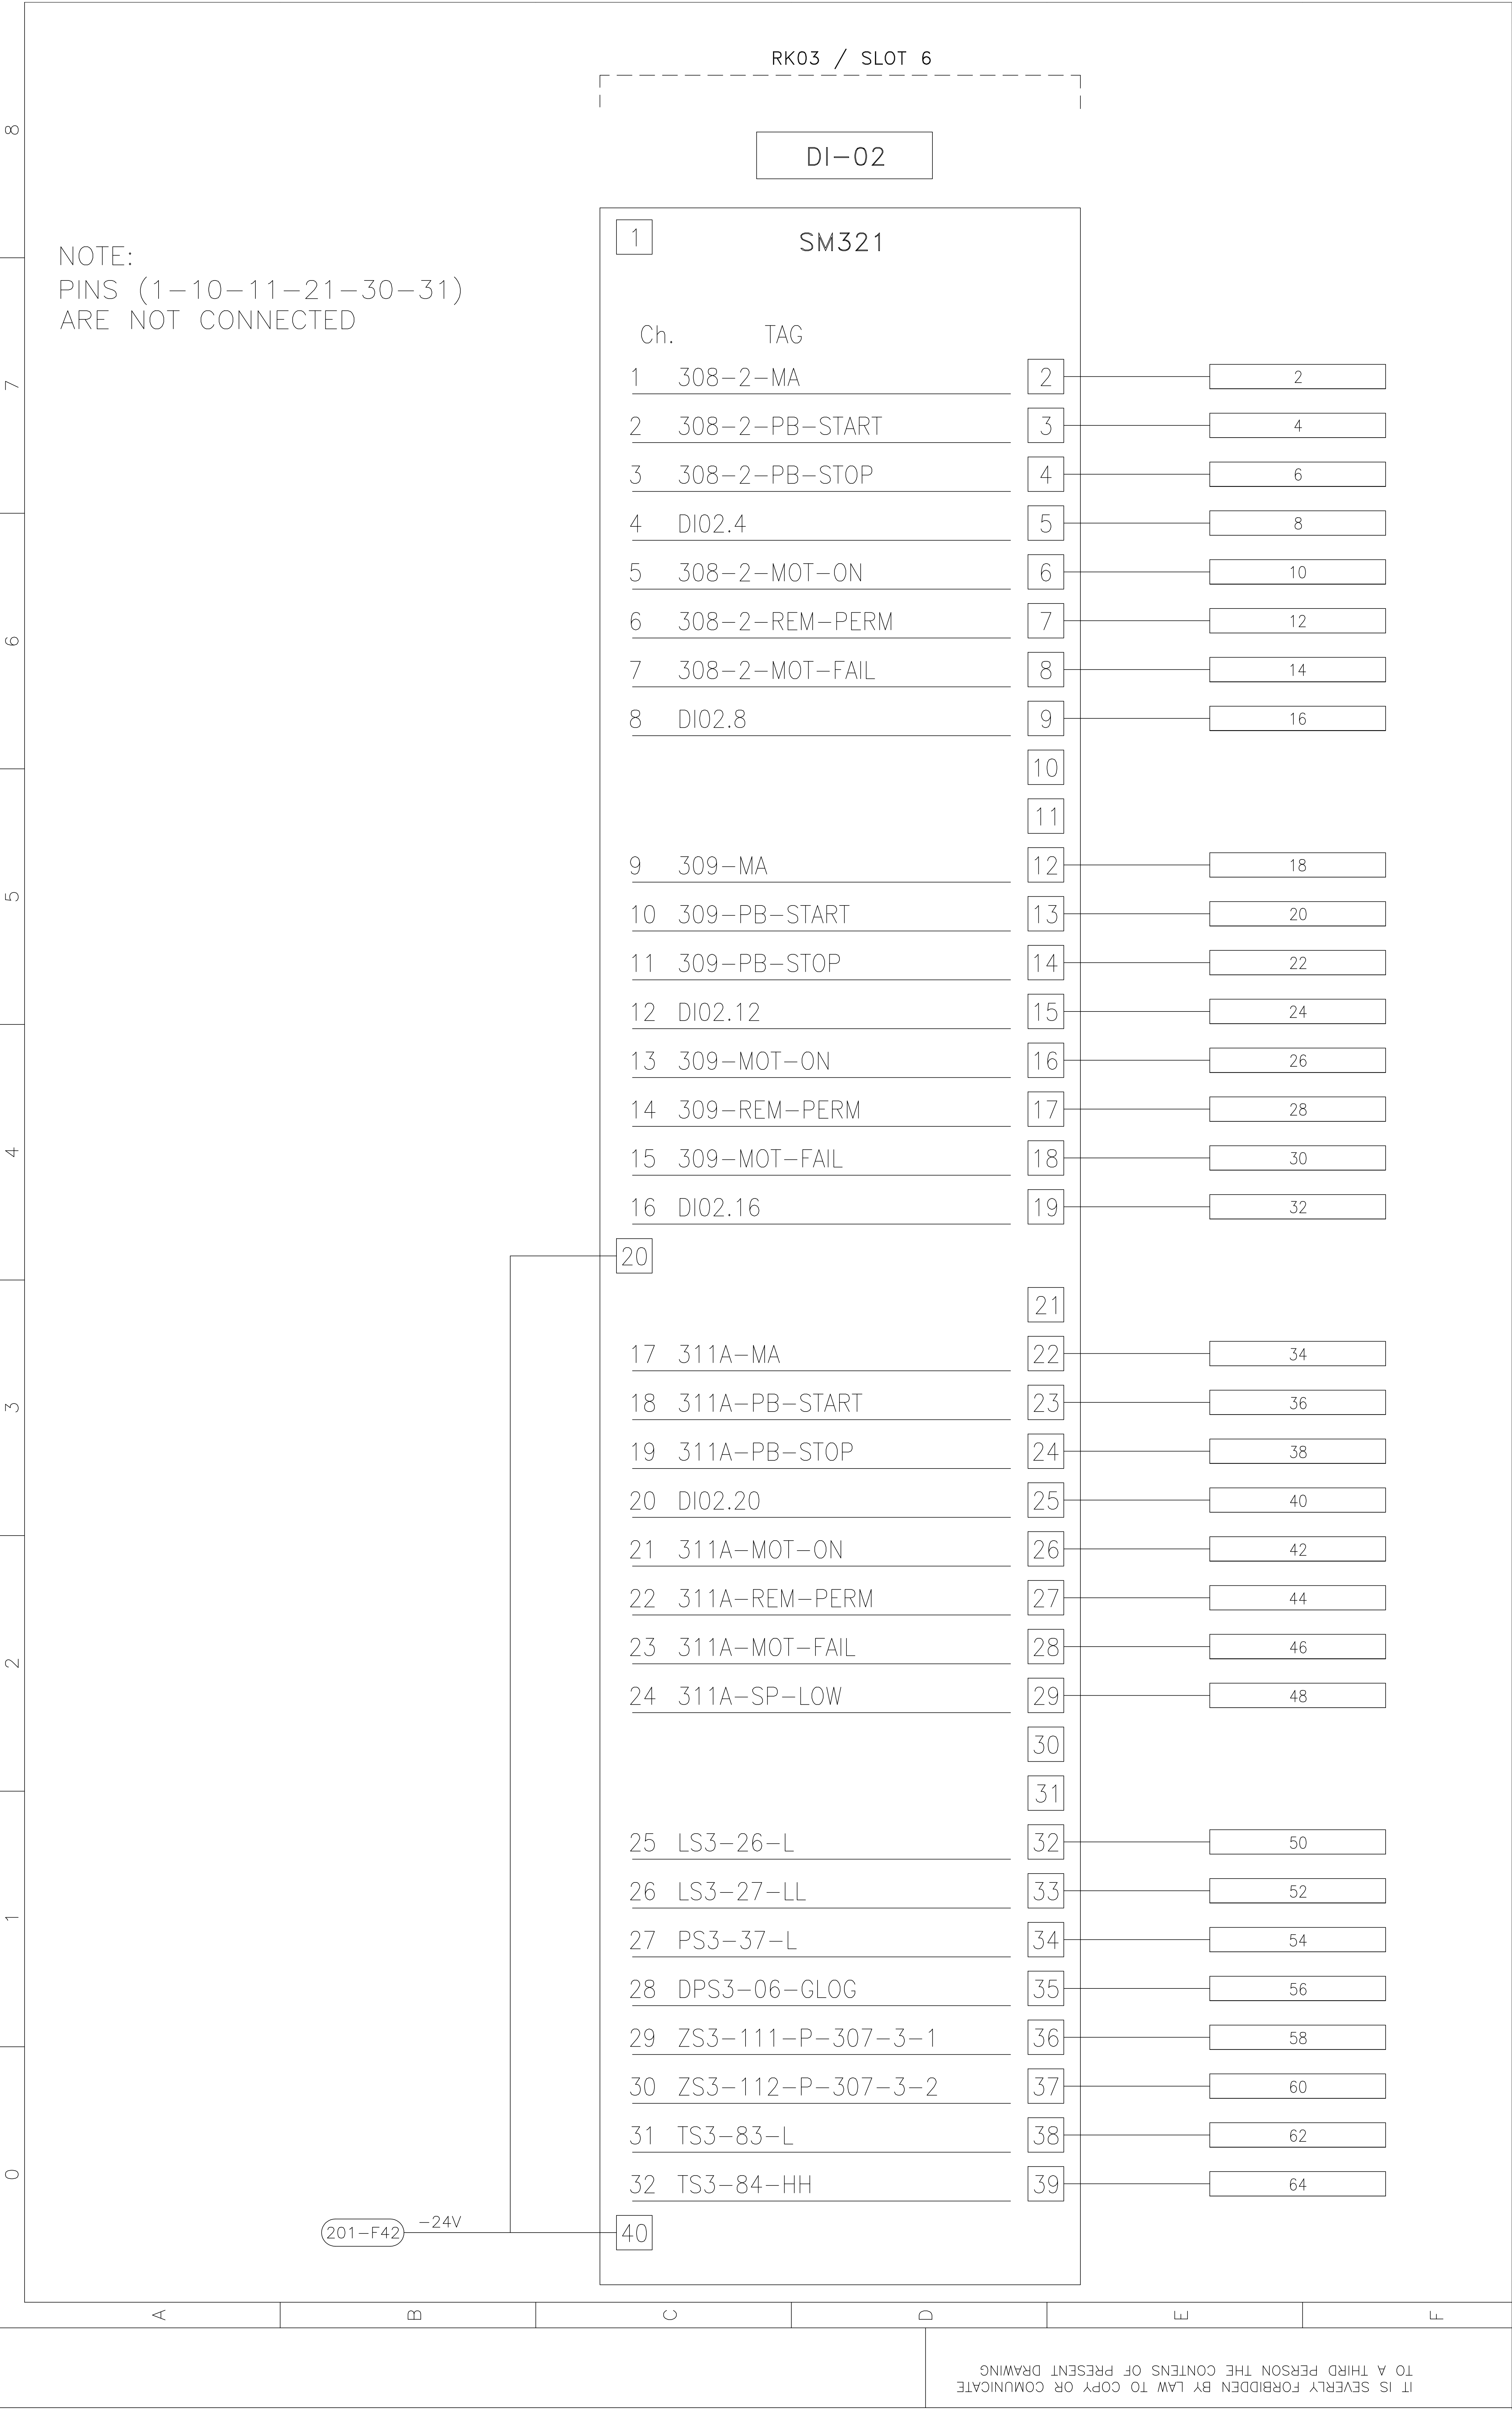

INTELISOFT

NOTE

ASBUILT

PLANT LOCATION

ASCC ALEXANDRIA

SECTION

DI02 - DIGITAL INPUT WIRING DIAGRAM

DOC. TYPE

MAERZ - CABINET LAYOUT

CLIENT

ASCC

JOB

ID7854

DWG N.

ASCC_MRZ-2102

FILE NAME

ASCC_MRZ-2102-027

DATE

30/5/2006

REV

00

PREV


26

PAGE

27

NEX

28

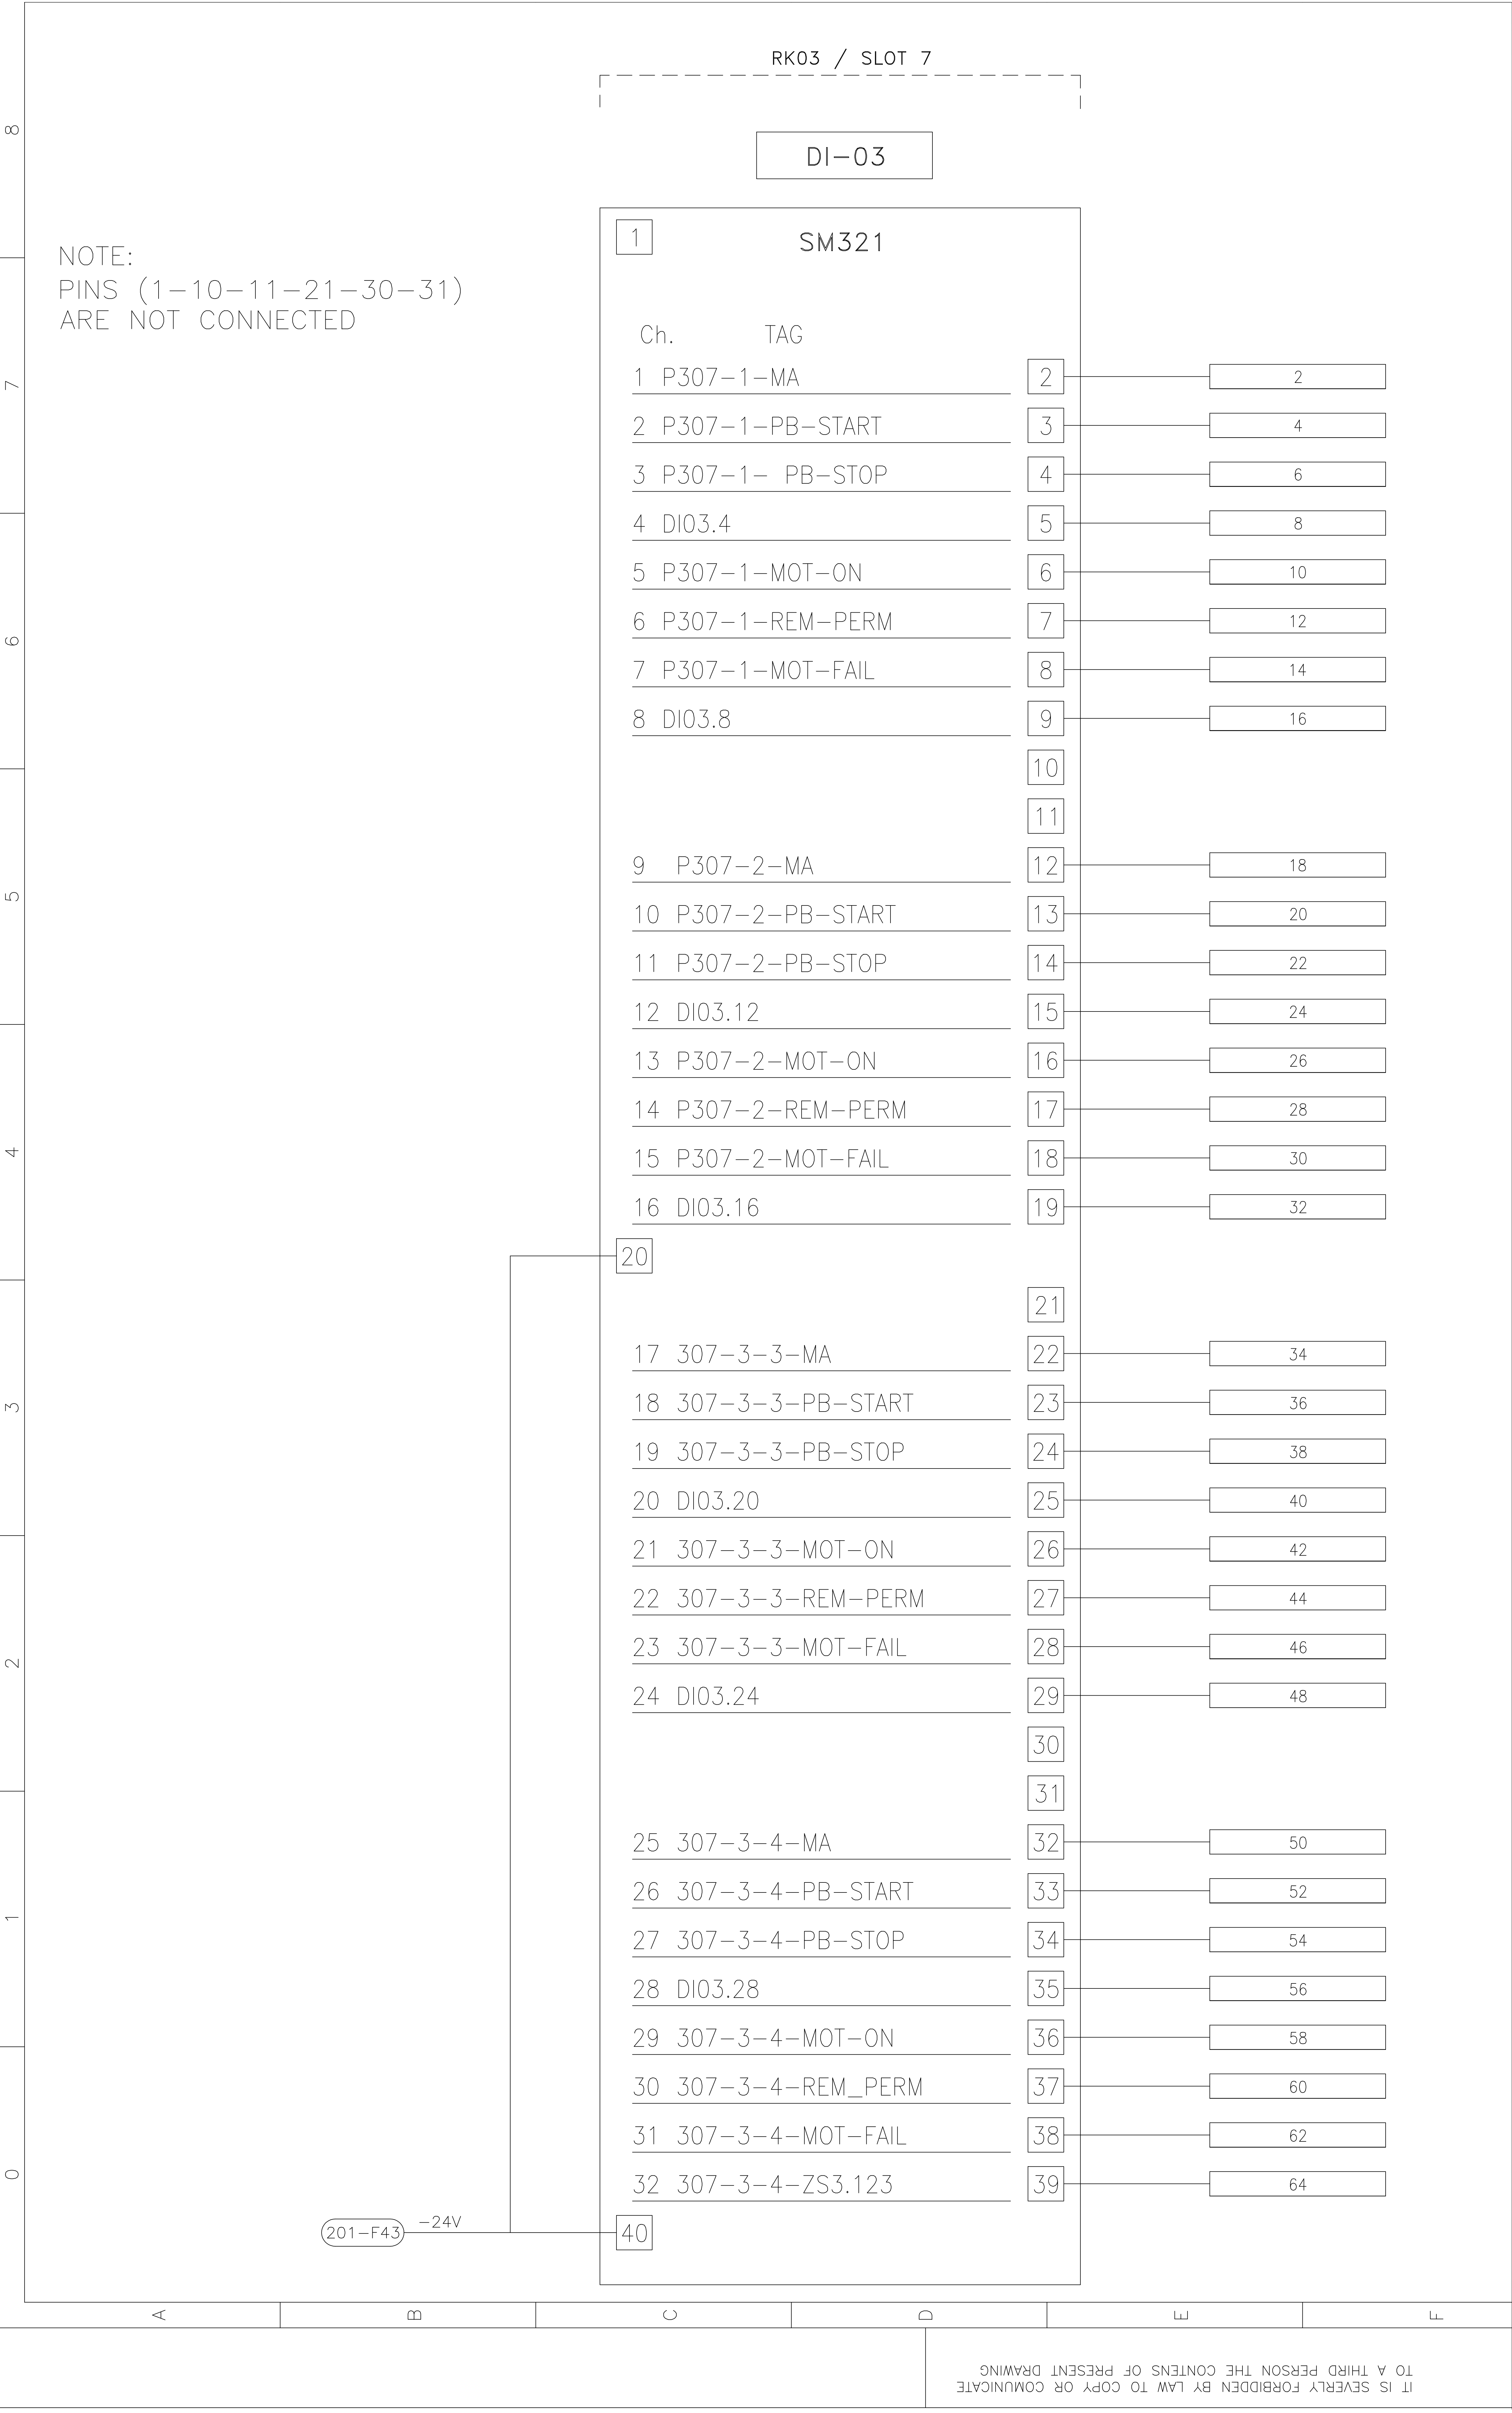

INTELISOFT

ORI

SOFT

Process Automation

NOTE

ASBUILT

PLANT LOCATION

ASCC ALEXANDRIA

SECTION

DI03 - DIGITAL INPUT WIRING DIAGRAM

DOC. TYPE

MAERZ - CABINET LAYOUT

CLIENT

ASCC

JOB

ID7854

DWG N.

ASCC_MRZ-2102

FILE NAME

ASCC_MRZ-2102-028

DATE

30/5/2006

REV

00

PREV


27

PAGE

28

NEX

29

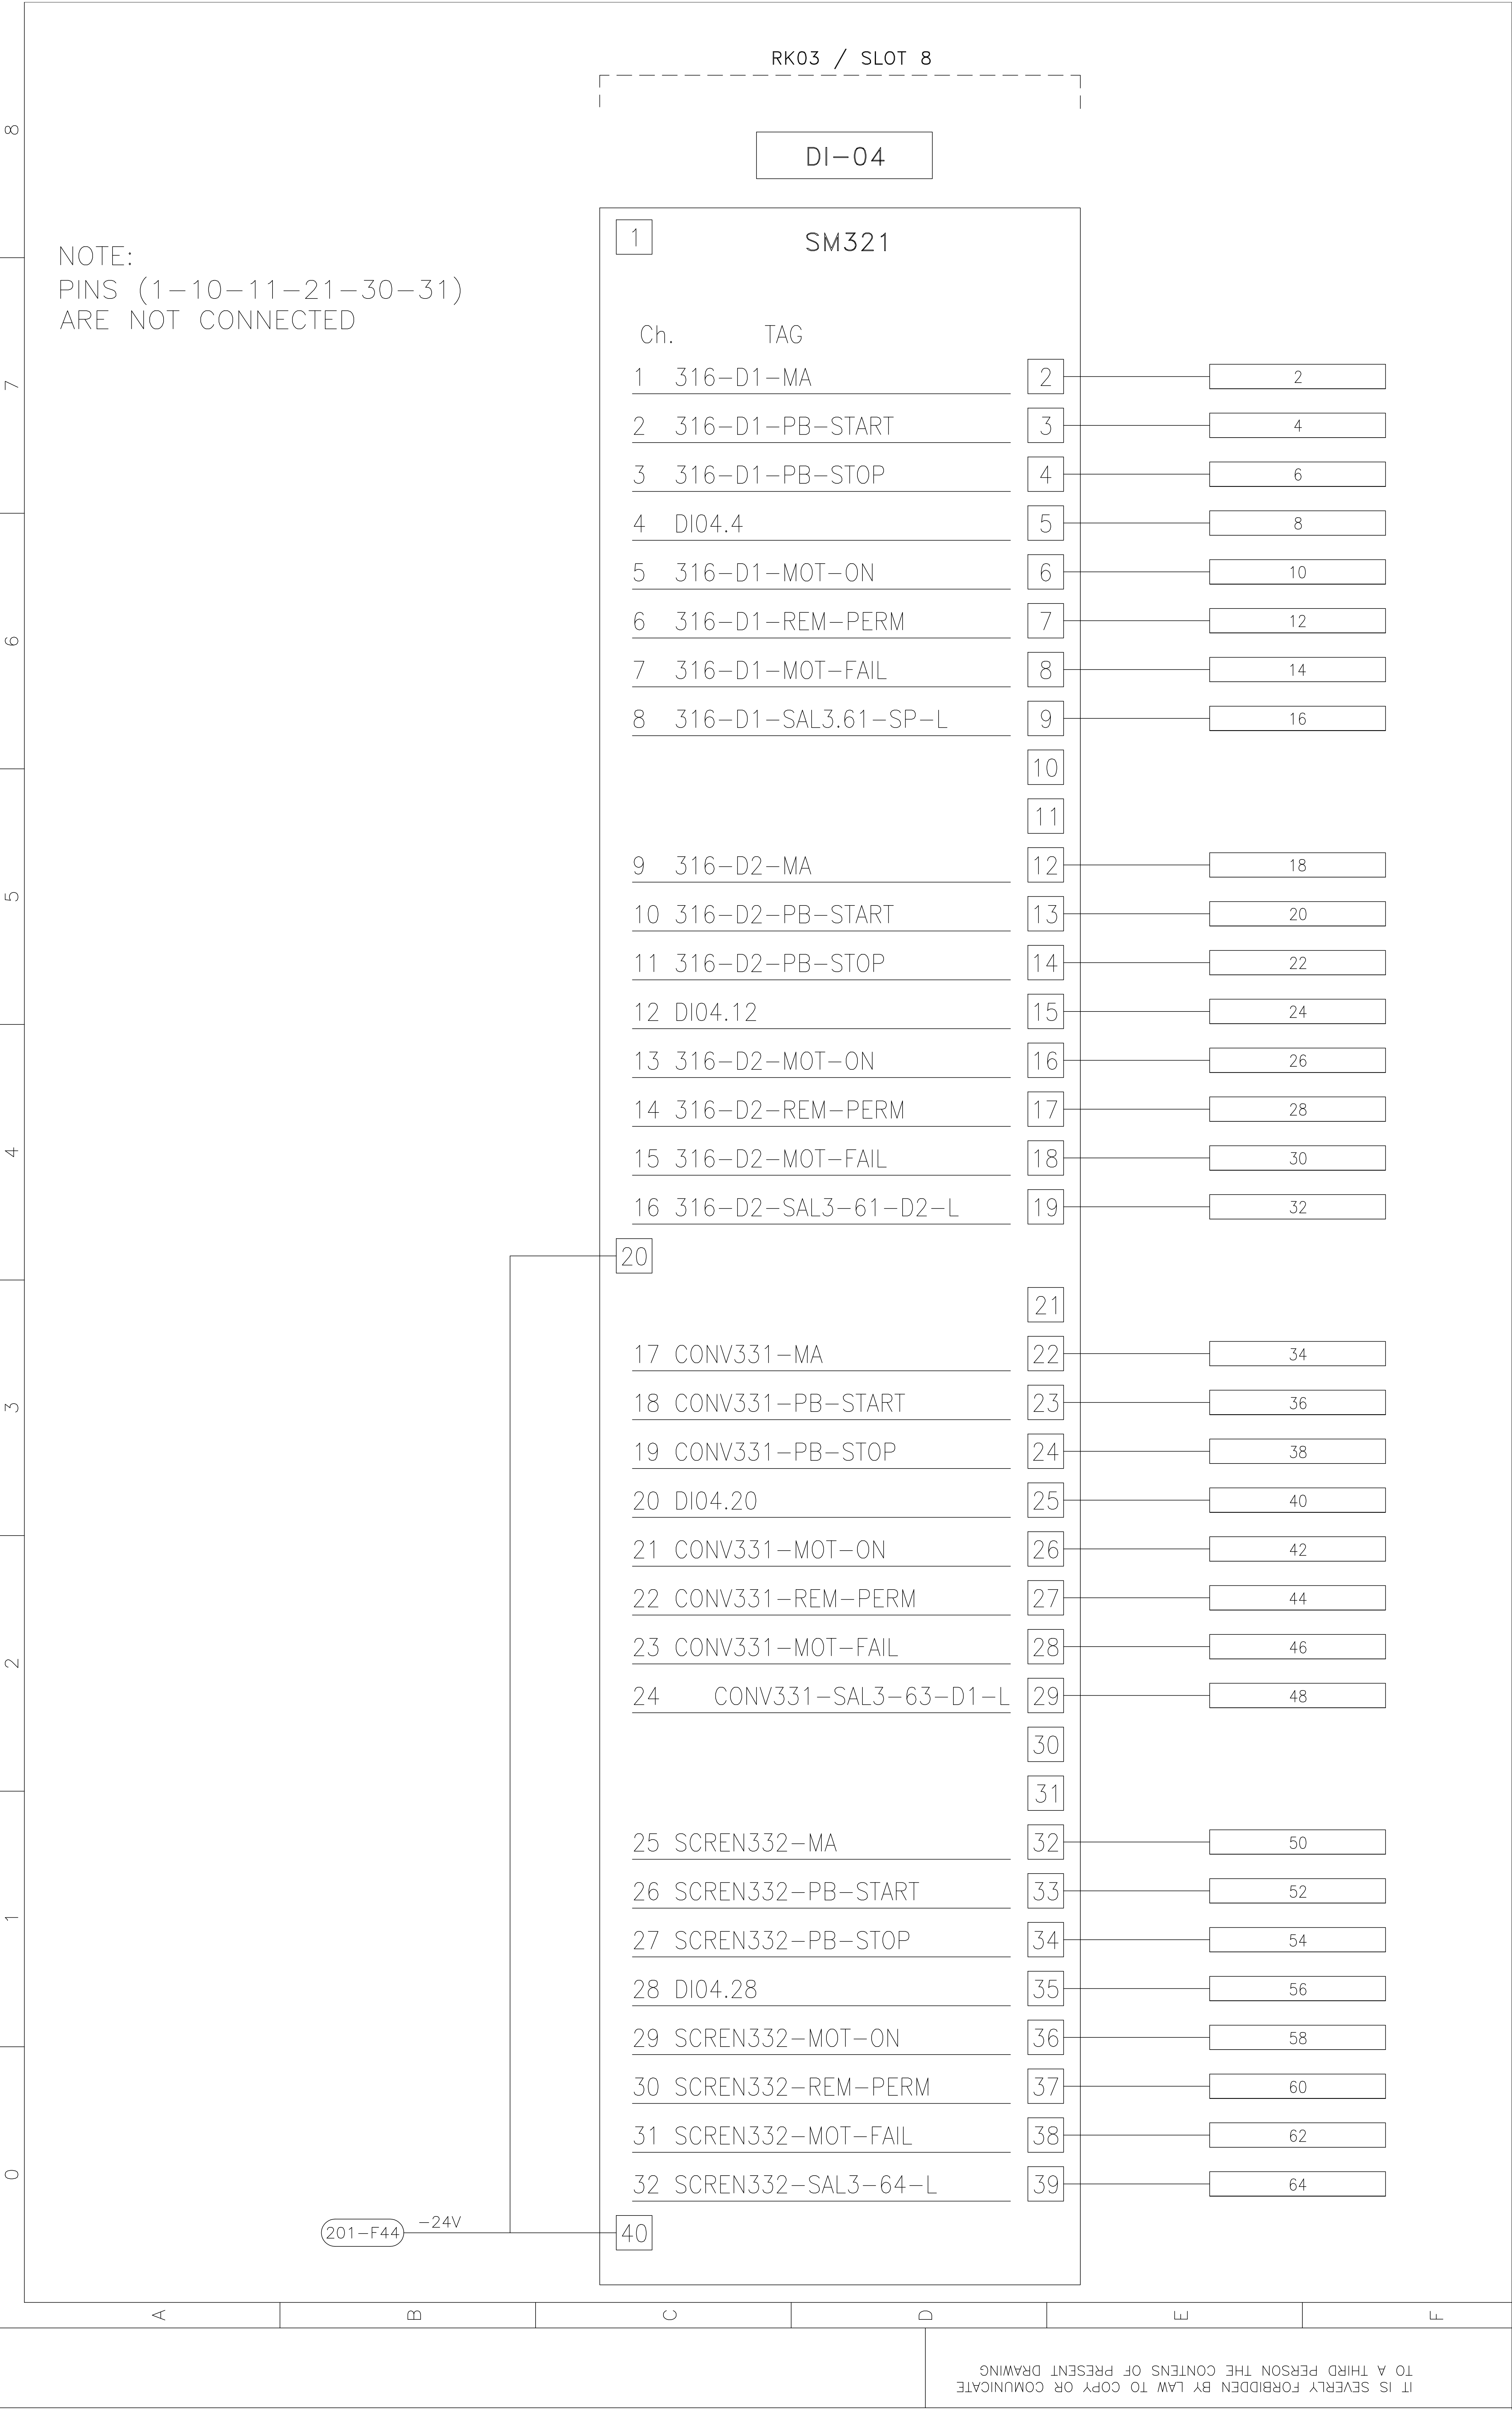

RK03 / SLOT 8

DI-04

1

SM321

Ch.

TAG

1

316-D1-MA

2

316-D1-PB-START

3

316-D1-PB-STOP

4

DI04.4

5

316-D1-MOT-ON

6

316-D1-REM-PERM

7

316-D1-MOT-FAIL

8

316-D1-SAL3.61-SP-L

9

316-D2-MA

10

316-D2-PB-START

11

316-D2-PB-STOP

12

DI04.12

13

316-D2-MOT-ON

14

316-D2-REM-PERM

15

316-D2-MOT-FAIL

16

316-D2-SAL3-61-D2-L

17

CONV331-MA

18

CONV331-PB-START

19

CONV331-PB-STOP

20

DI04.20

21

CONV331-MOT-ON

22

CONV331-REM-PERM

23

CONV331-MOT-FAIL

24

CONV331-SAL3-63-D1-L

25

SCREN332-MA

26

SCREN332-PB-START

27

SCREN332-PB-STOP

28

DI04.28

29

SCREN332-MOT-ON

30

SCREN332-REM-PERM

31

SCREN332-MOT-FAIL

32

SCREN332-SAL3-64-L

2

2

4

6


64

201-F44


-24V


20

40

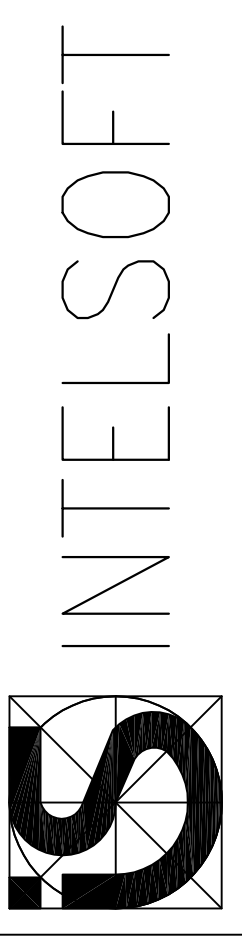

NOTE ASBUILT

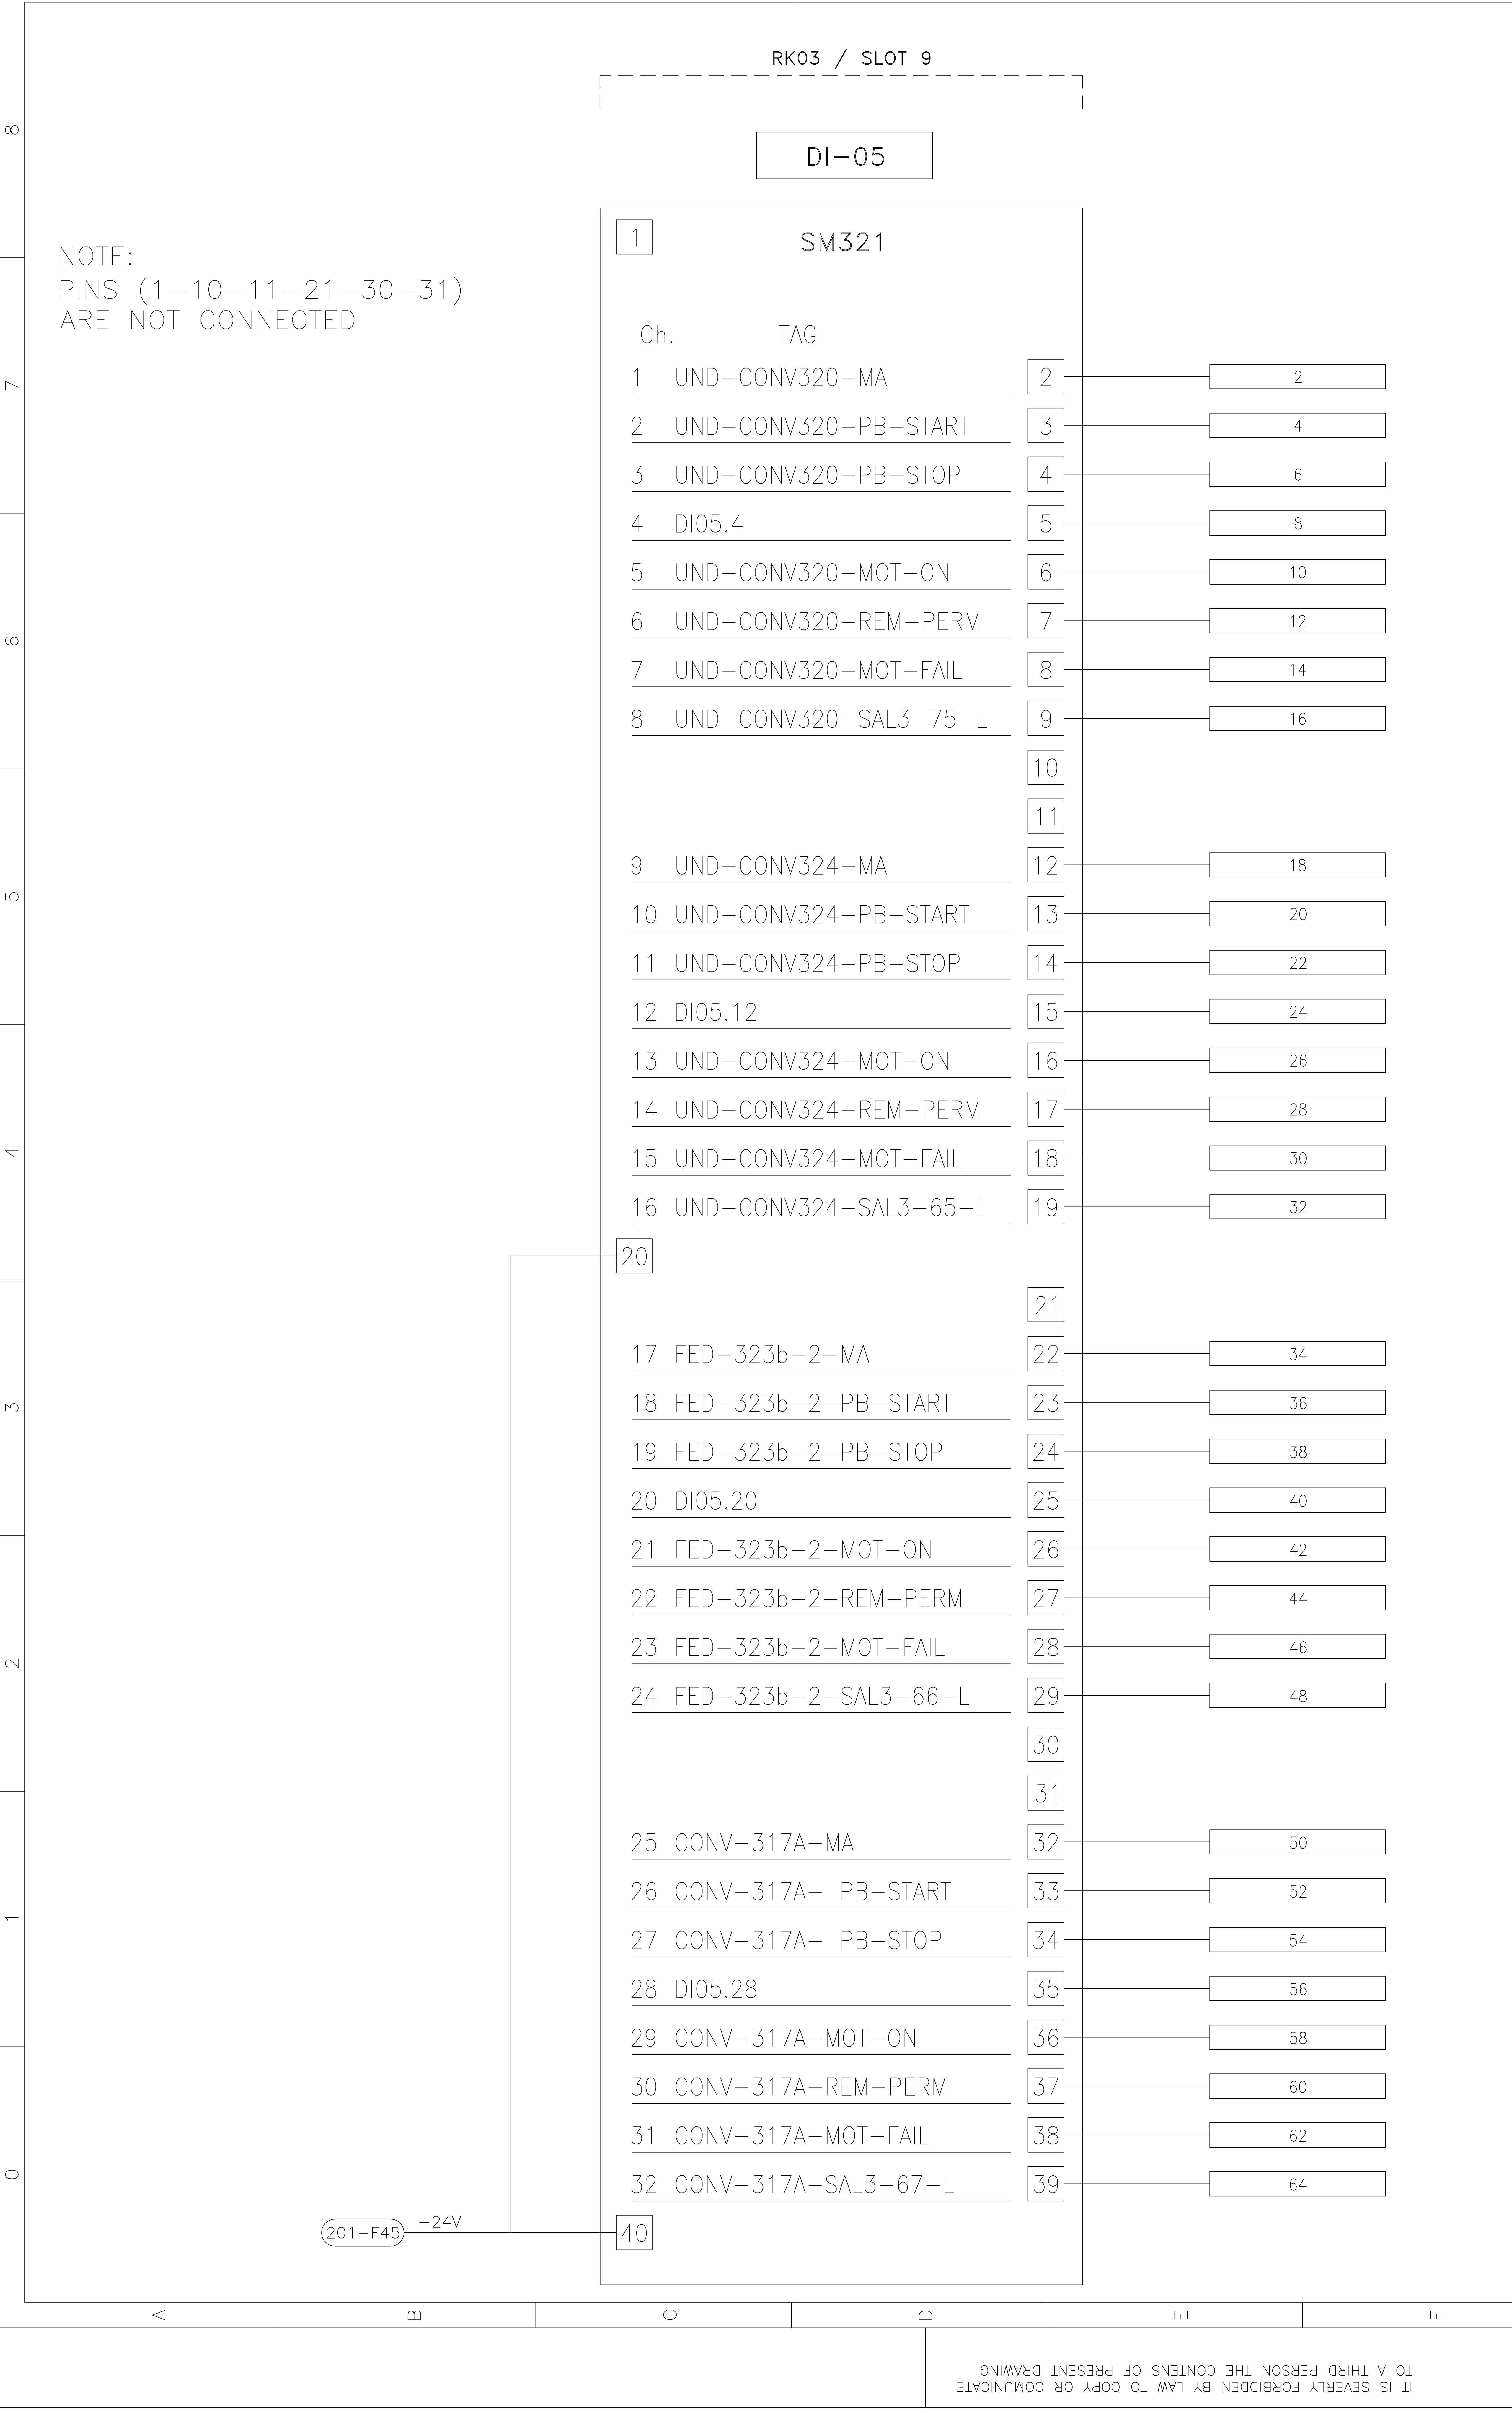

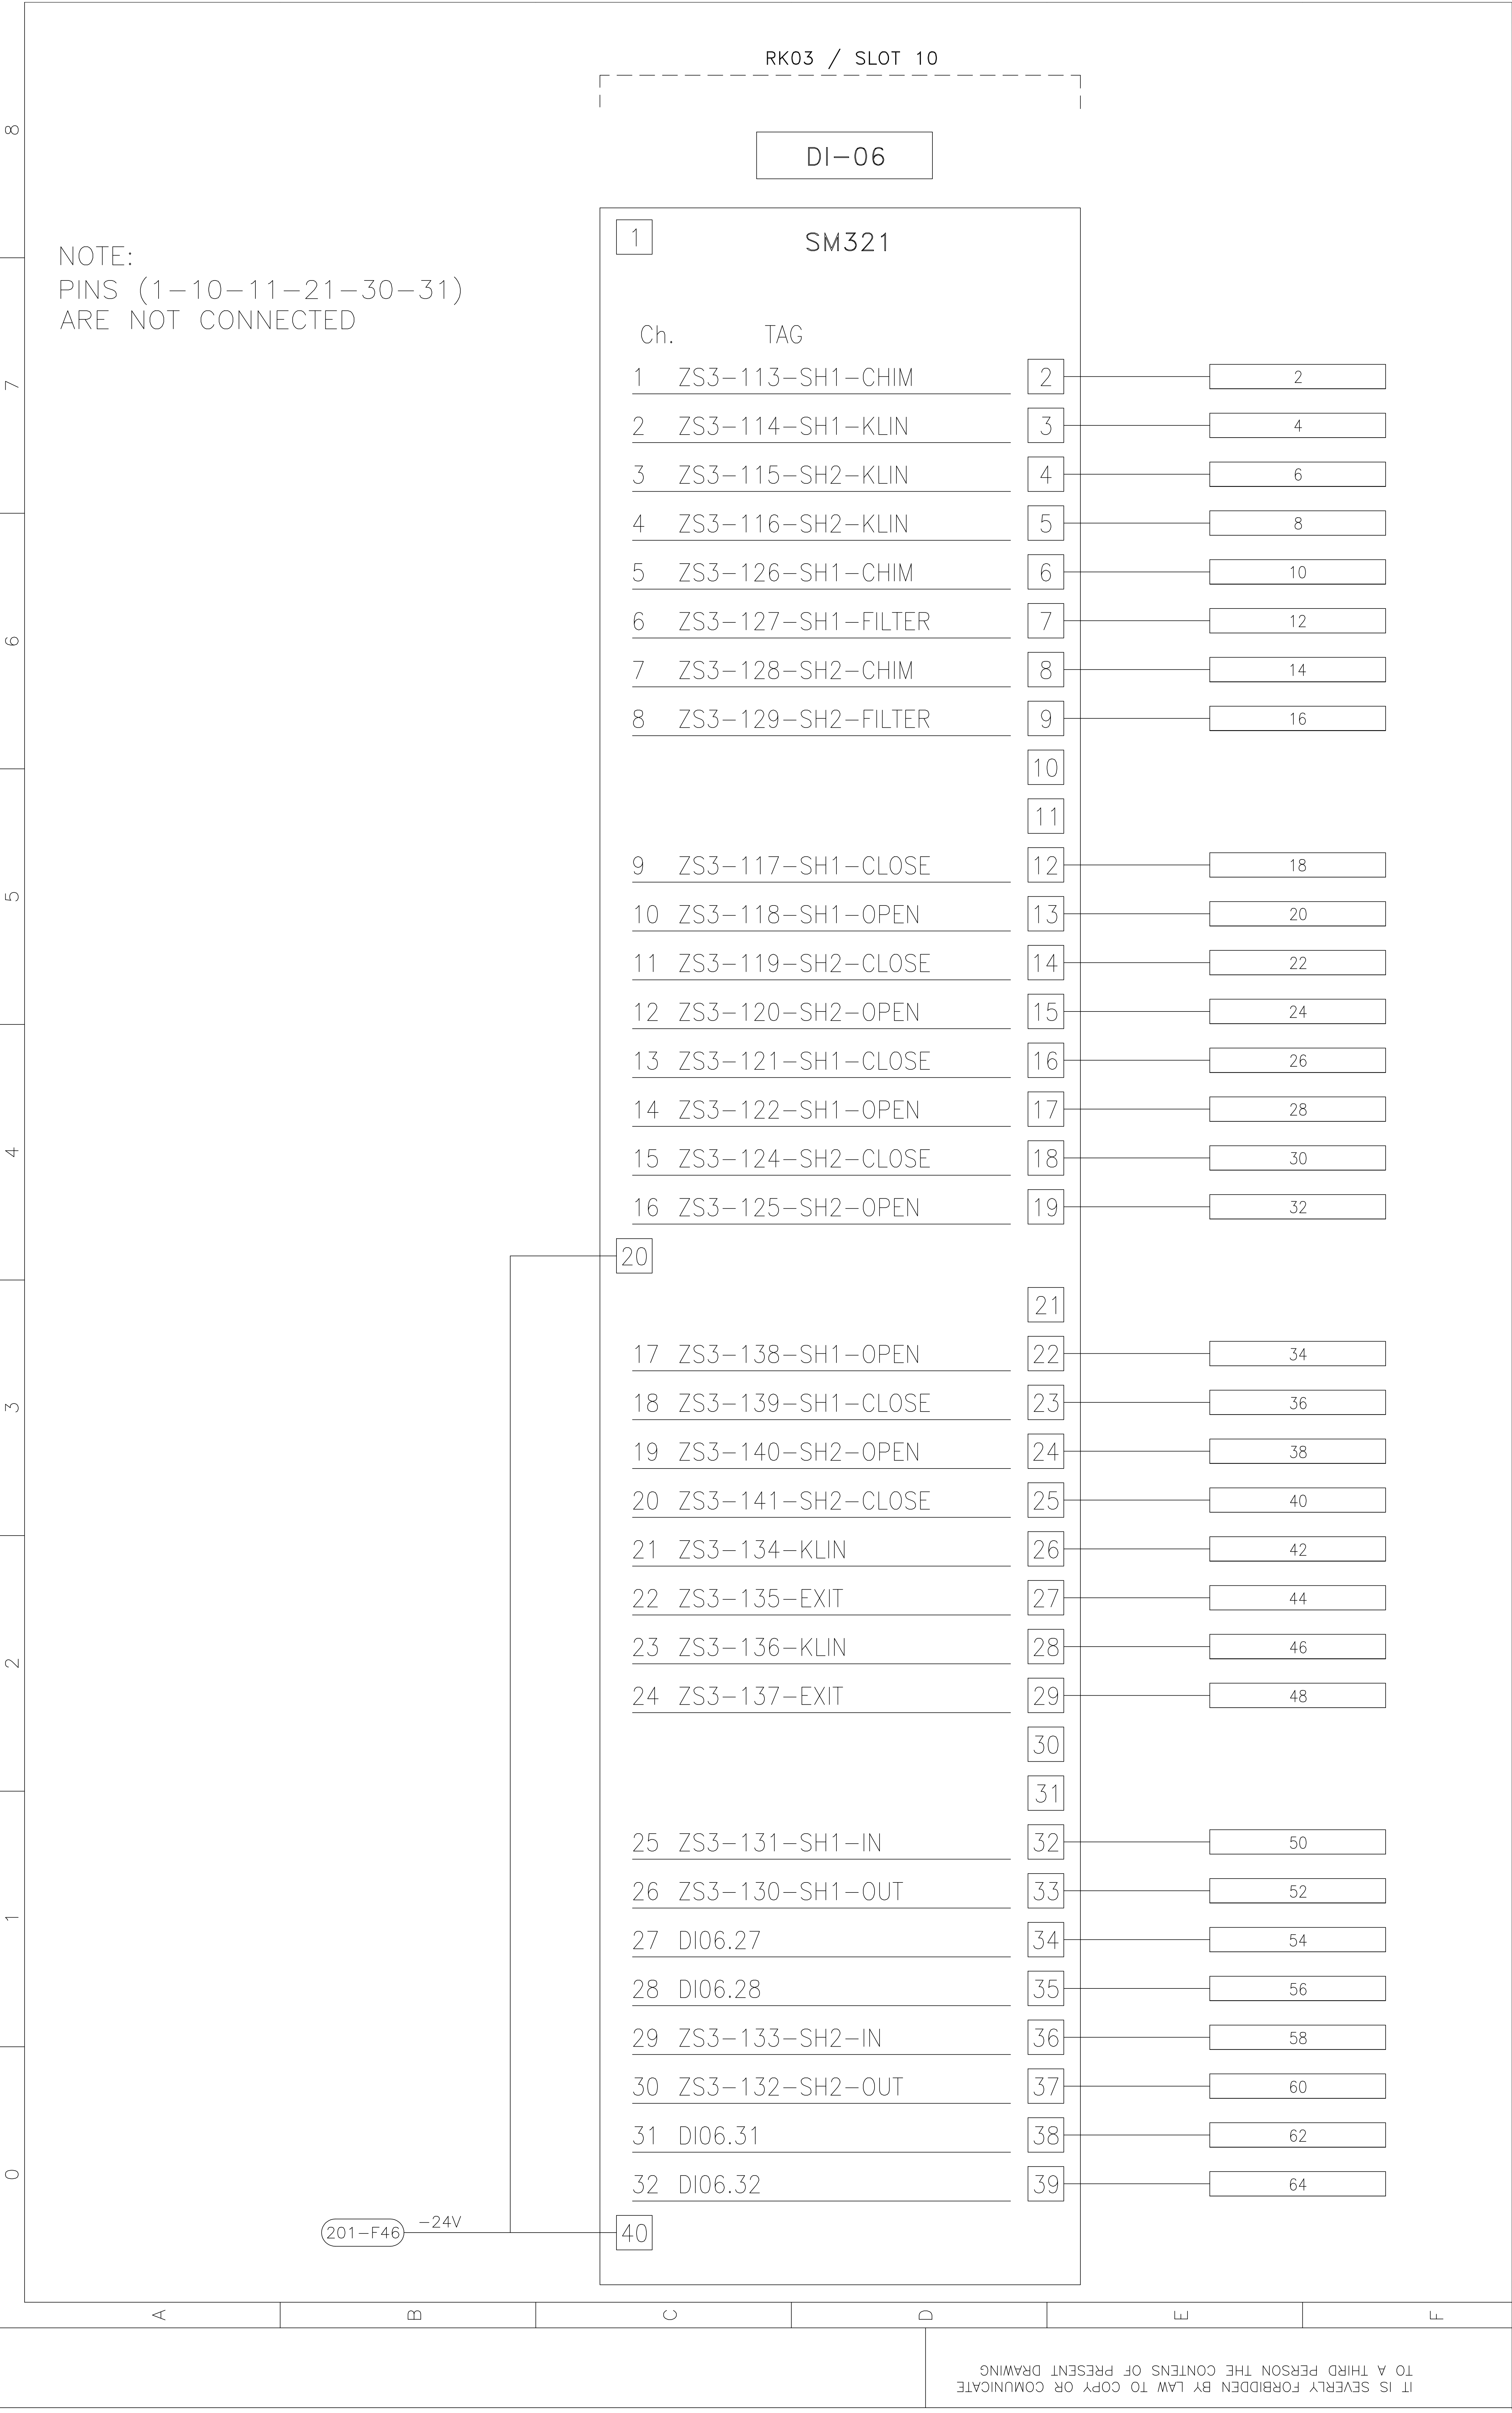

INTELISOFT

ORI

SOFT

Process Automation

NOTE

ASBUILT

PLANT LOCATION

ASCC ALEXANDRIA

SECTION

DI06 - DIGITAL INPUT WIRING DIAGRAM

DOC. TYPE

MAERZ - CABINET LAYOUT

CLIENT

ASCC

JOB

ID7854

DWG N.

ASCC_MRZ-2102

FILE NAME

ASCC_MRZ-2102-031

DATE

30/5/2006

REV

00

PREV


30


PAGE


31

NEX

32

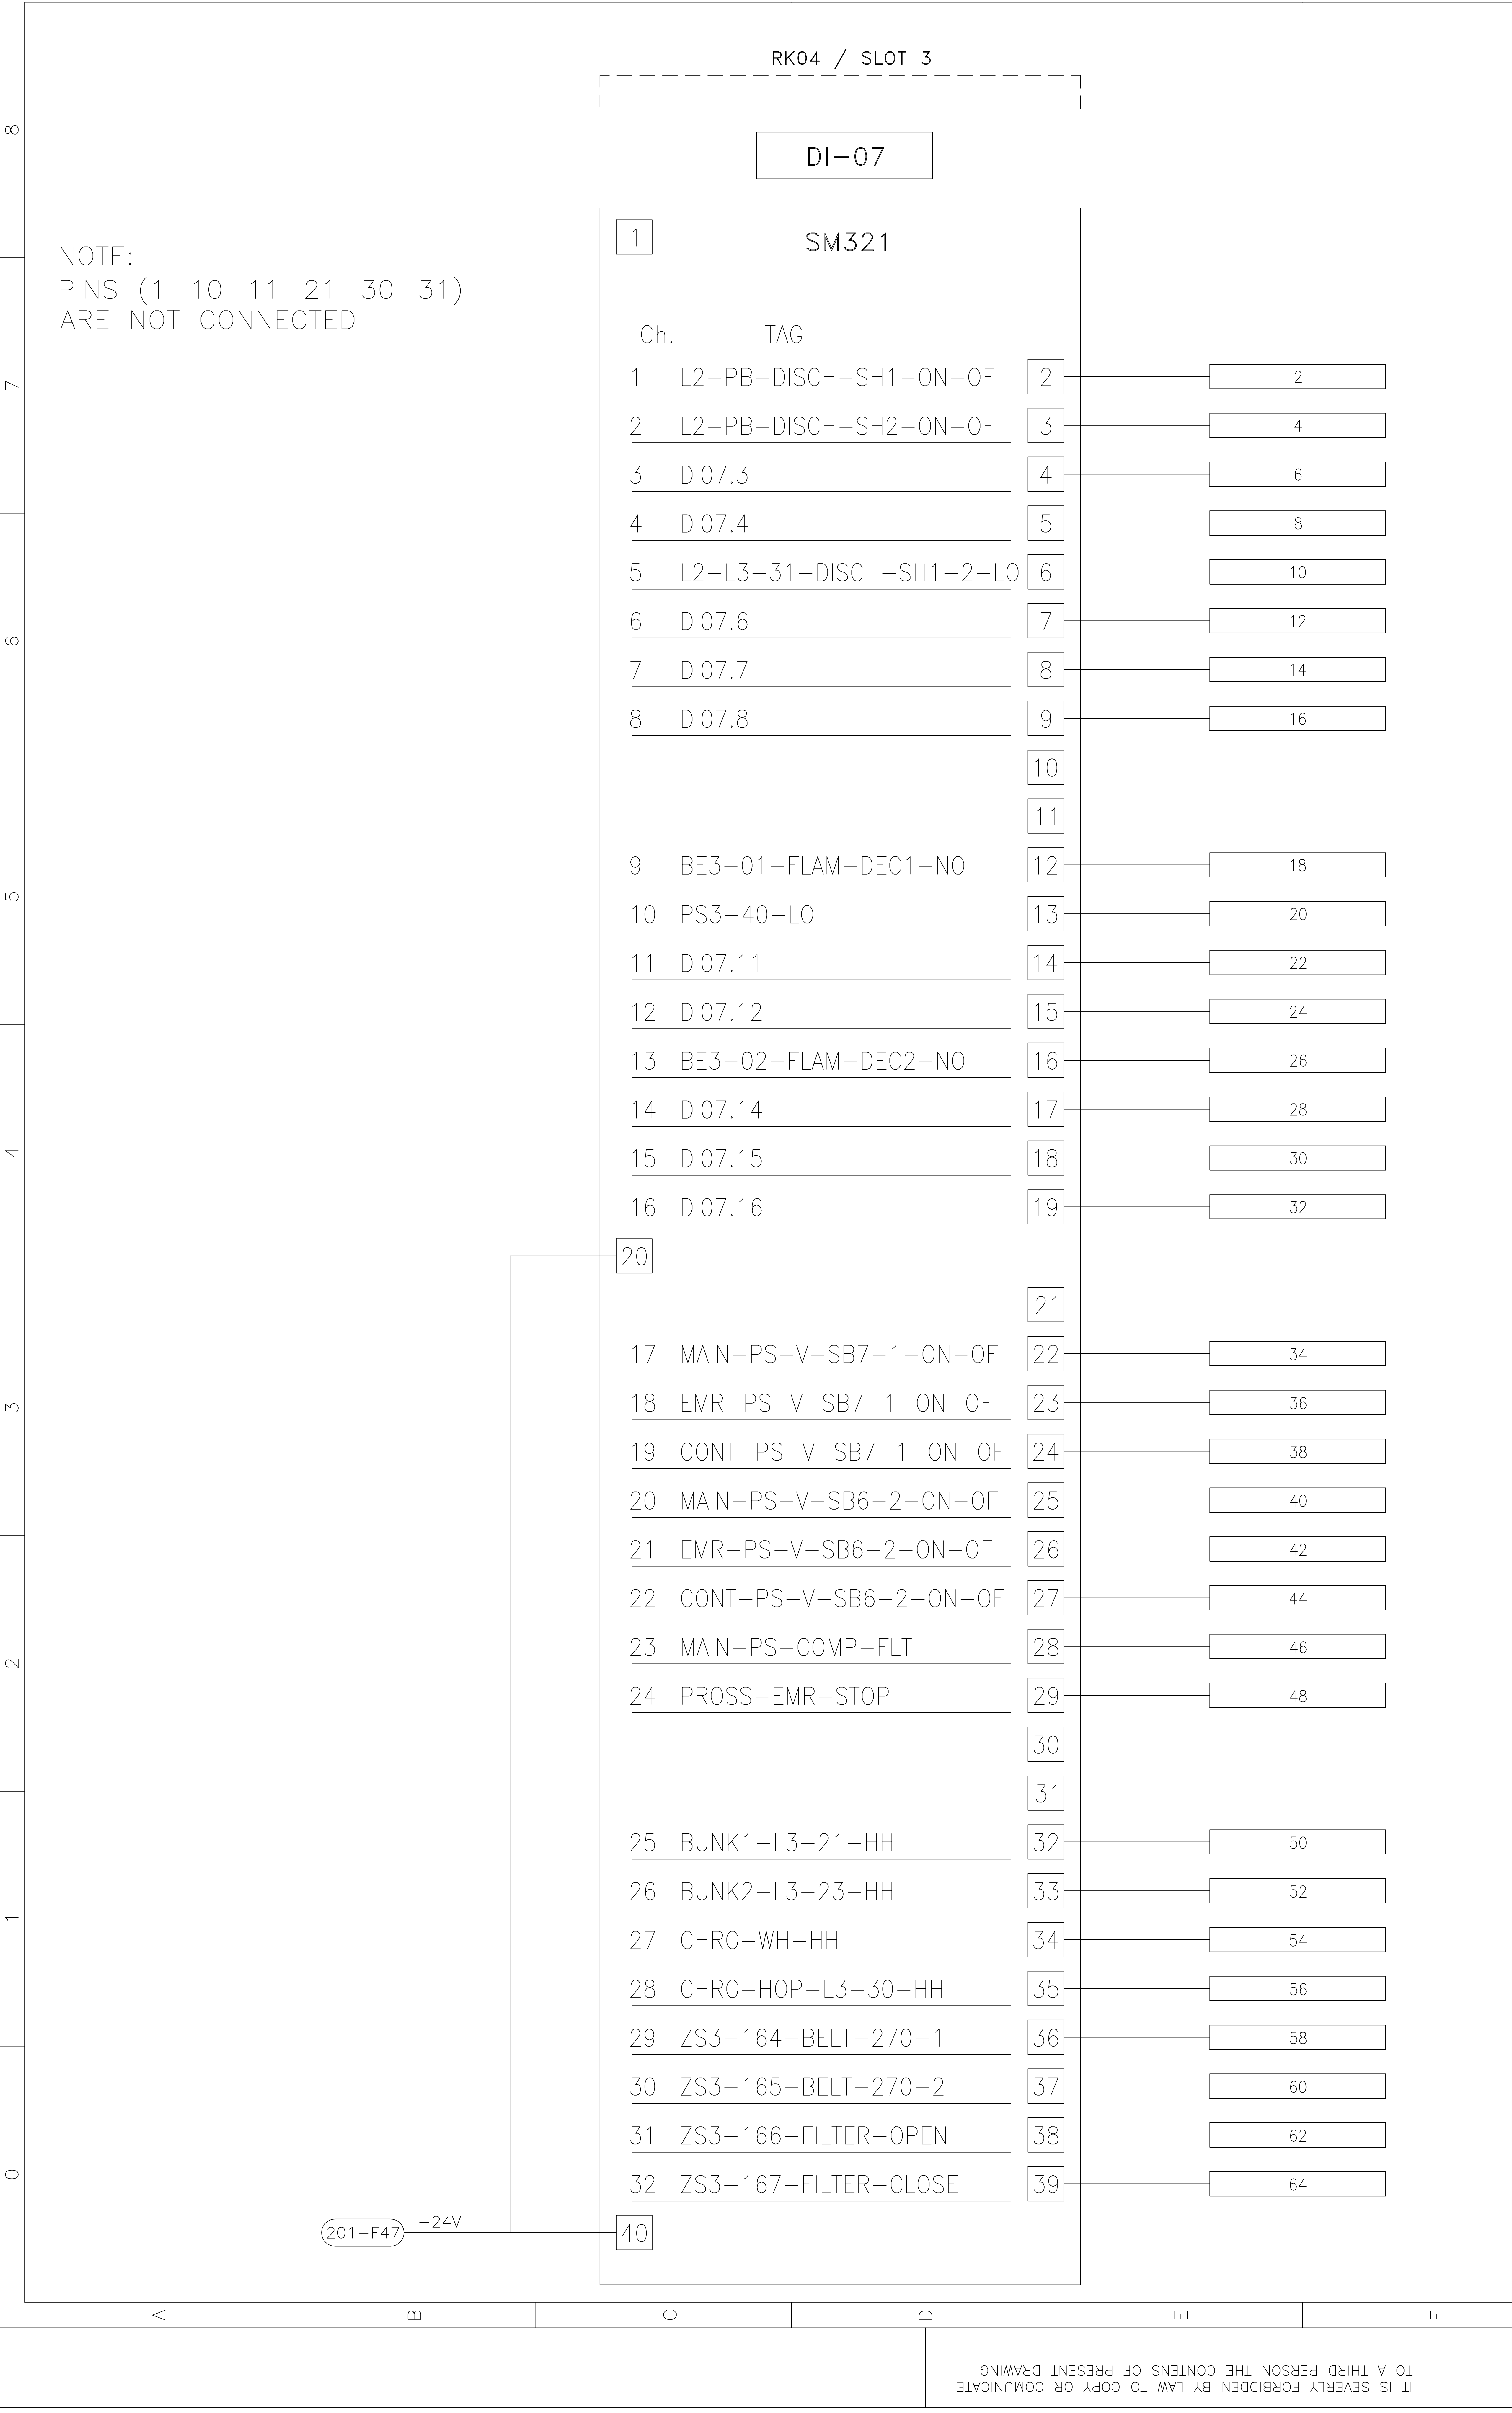

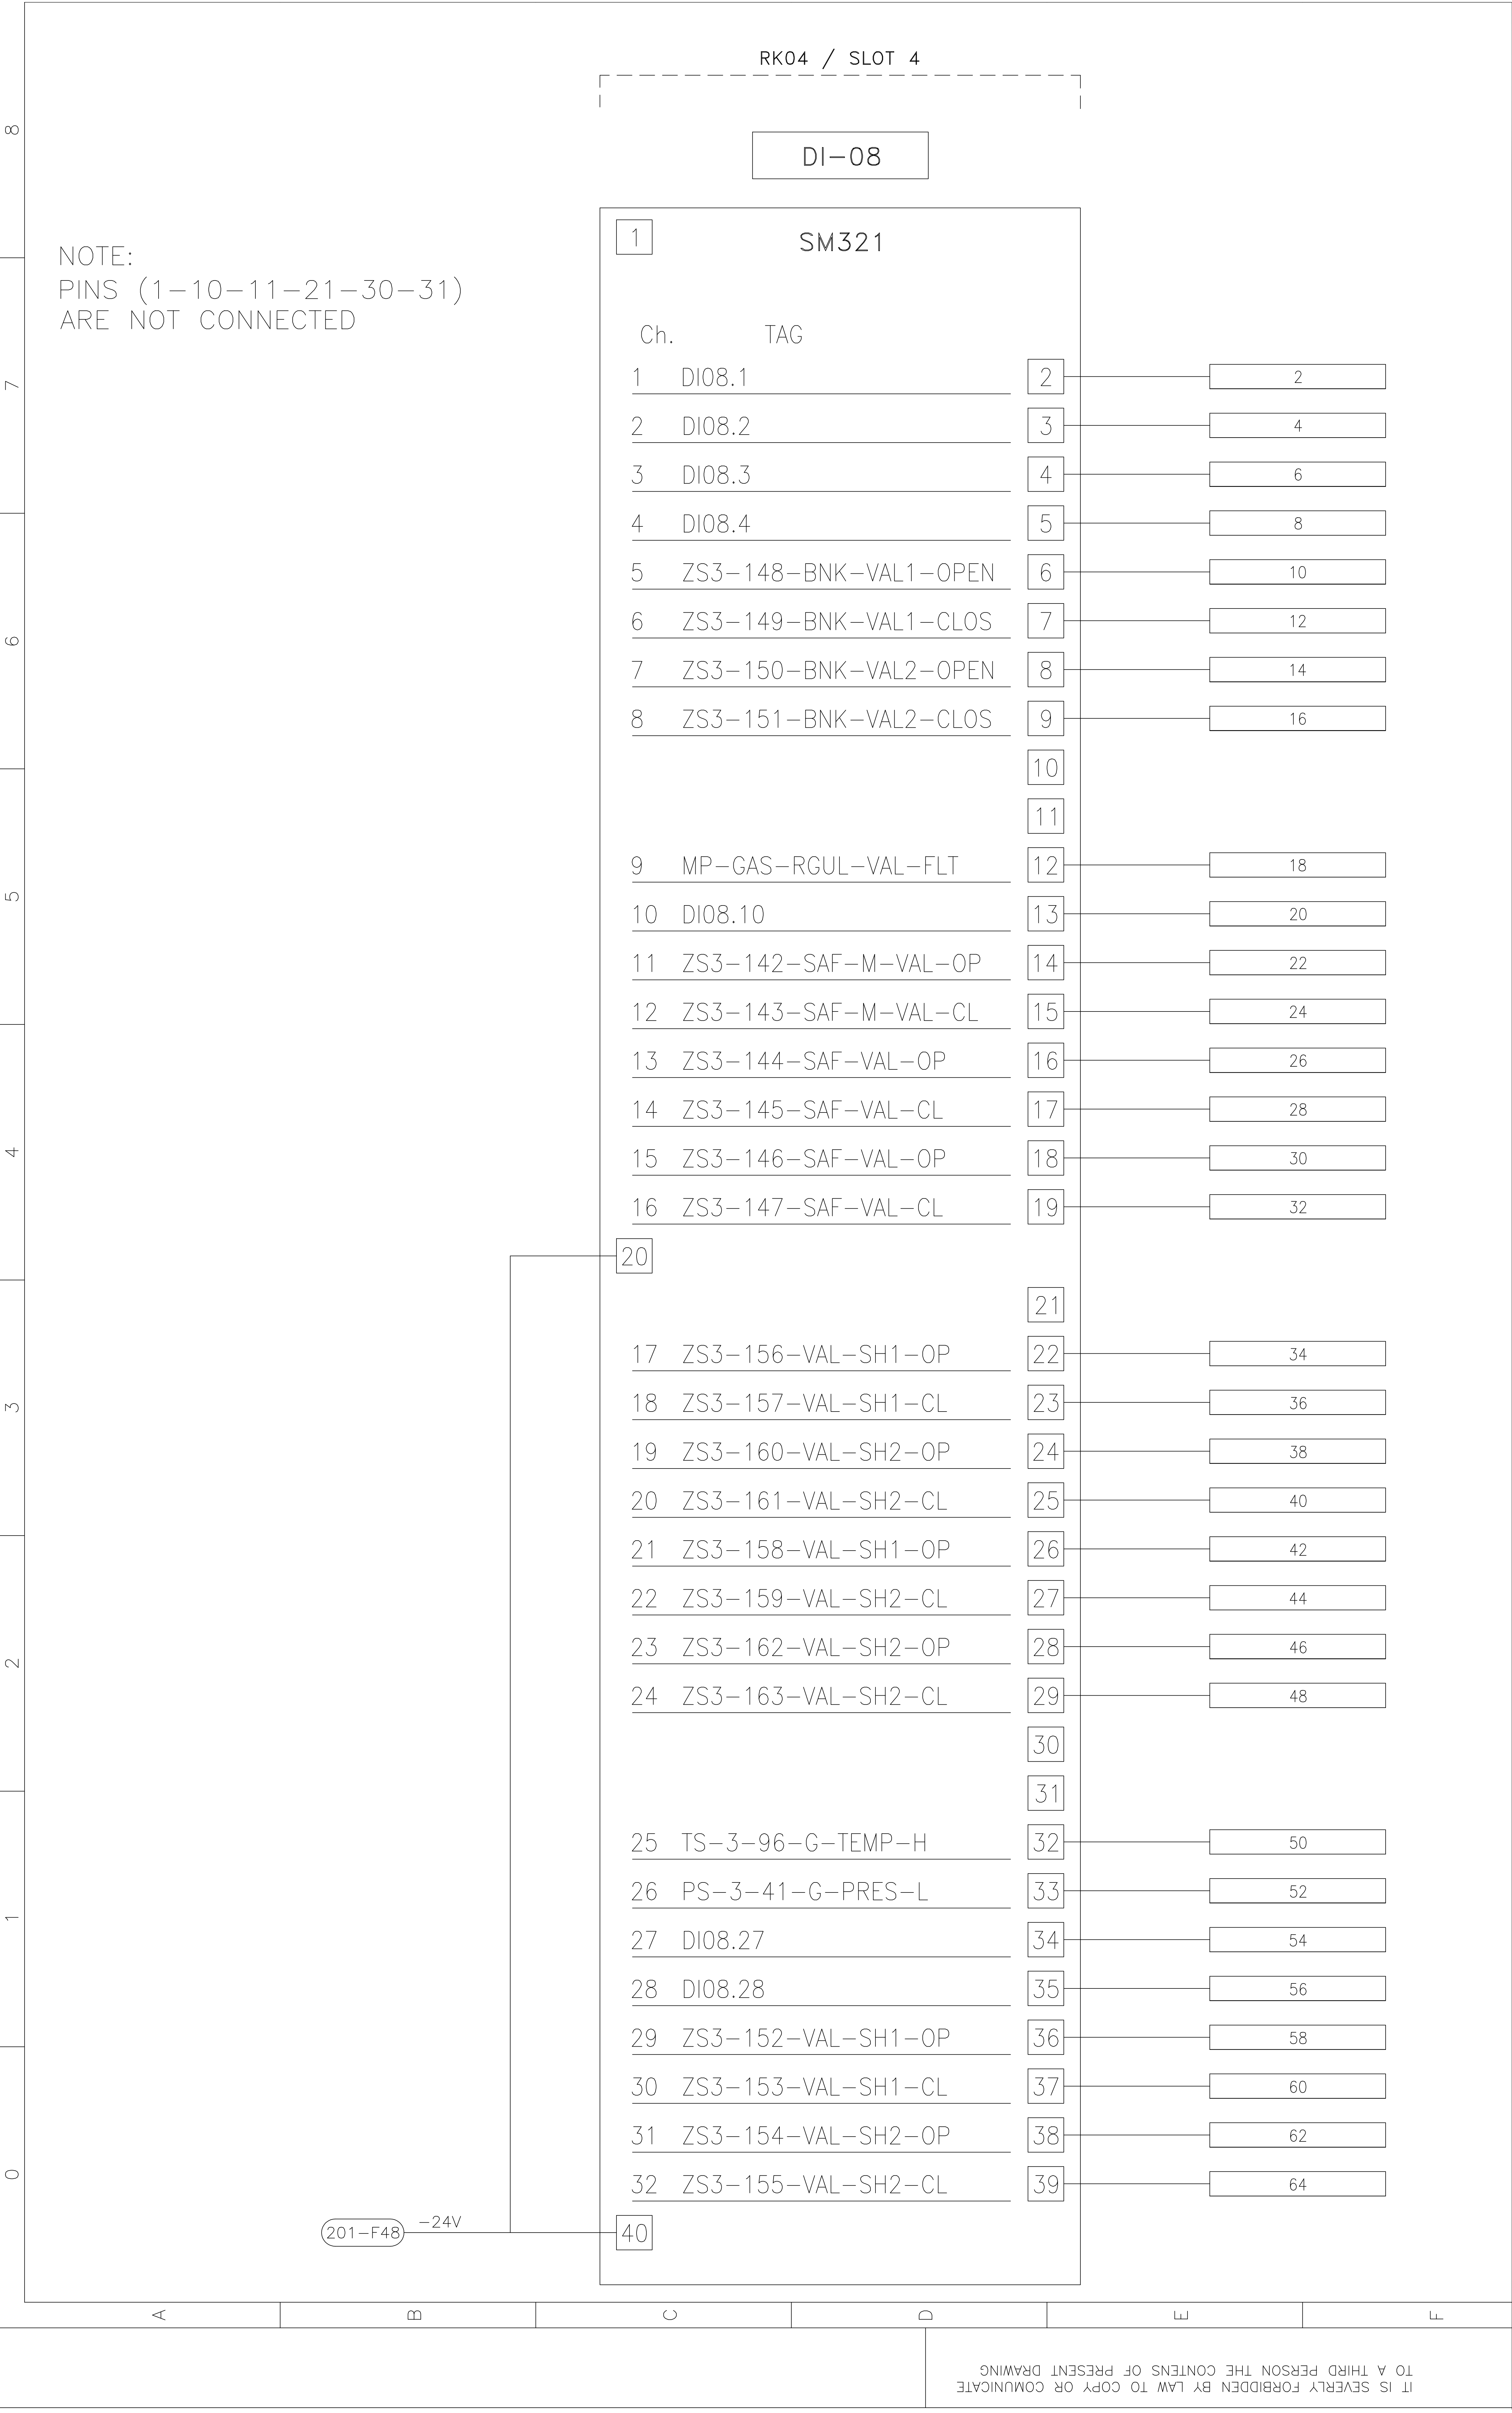

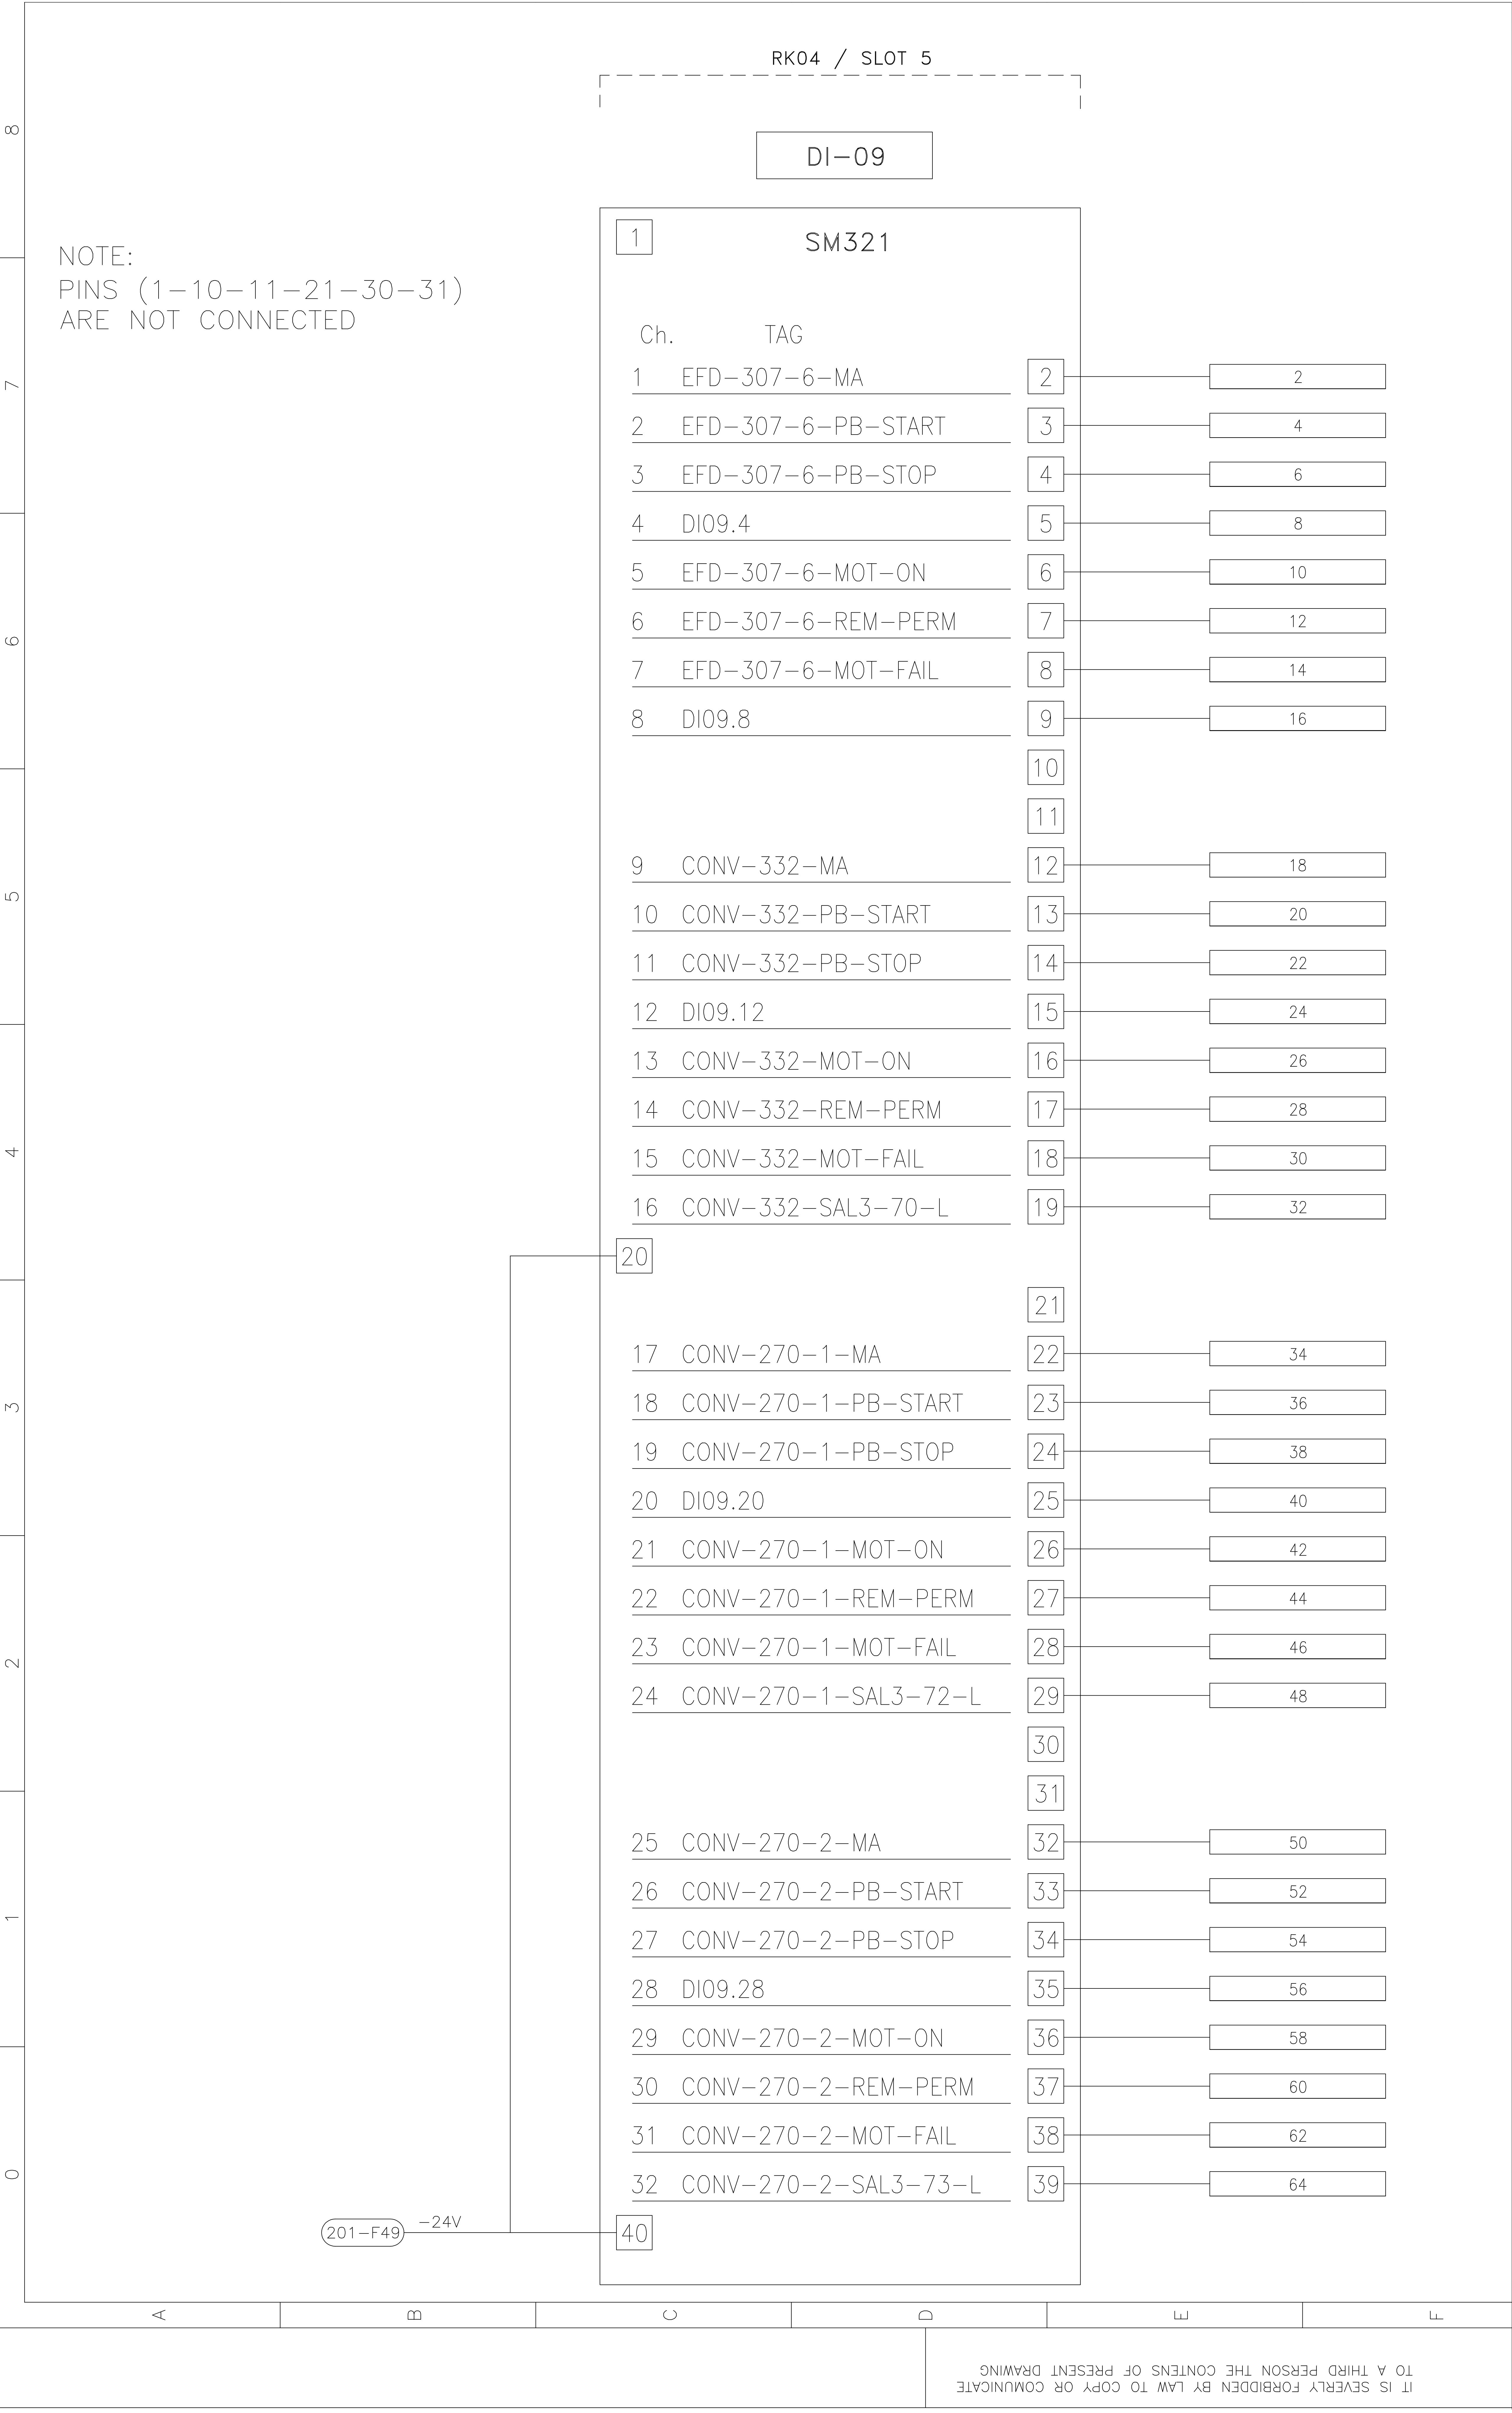

INTELISOFT

OR

SO

ORI

SOFT

Process Automation

NOTE

ASBUILT

PLANT LOCATION

ASCC ALEXANDRIA

SECTION

DI09 - DIGITAL INPUT WIRING DIAGRAM

DOC. TYPE

MAERZ - CABINET LAYOUT

CLIENT

ASCC

MAERZ

JOB

ID7854

DWG N.

ASCC_MRZ-2102

FILE NAME

ASCC_MRZ-2102-034

DATE

30/5/2006

REV

00

PREV


33

PAGE

34

NEX

35

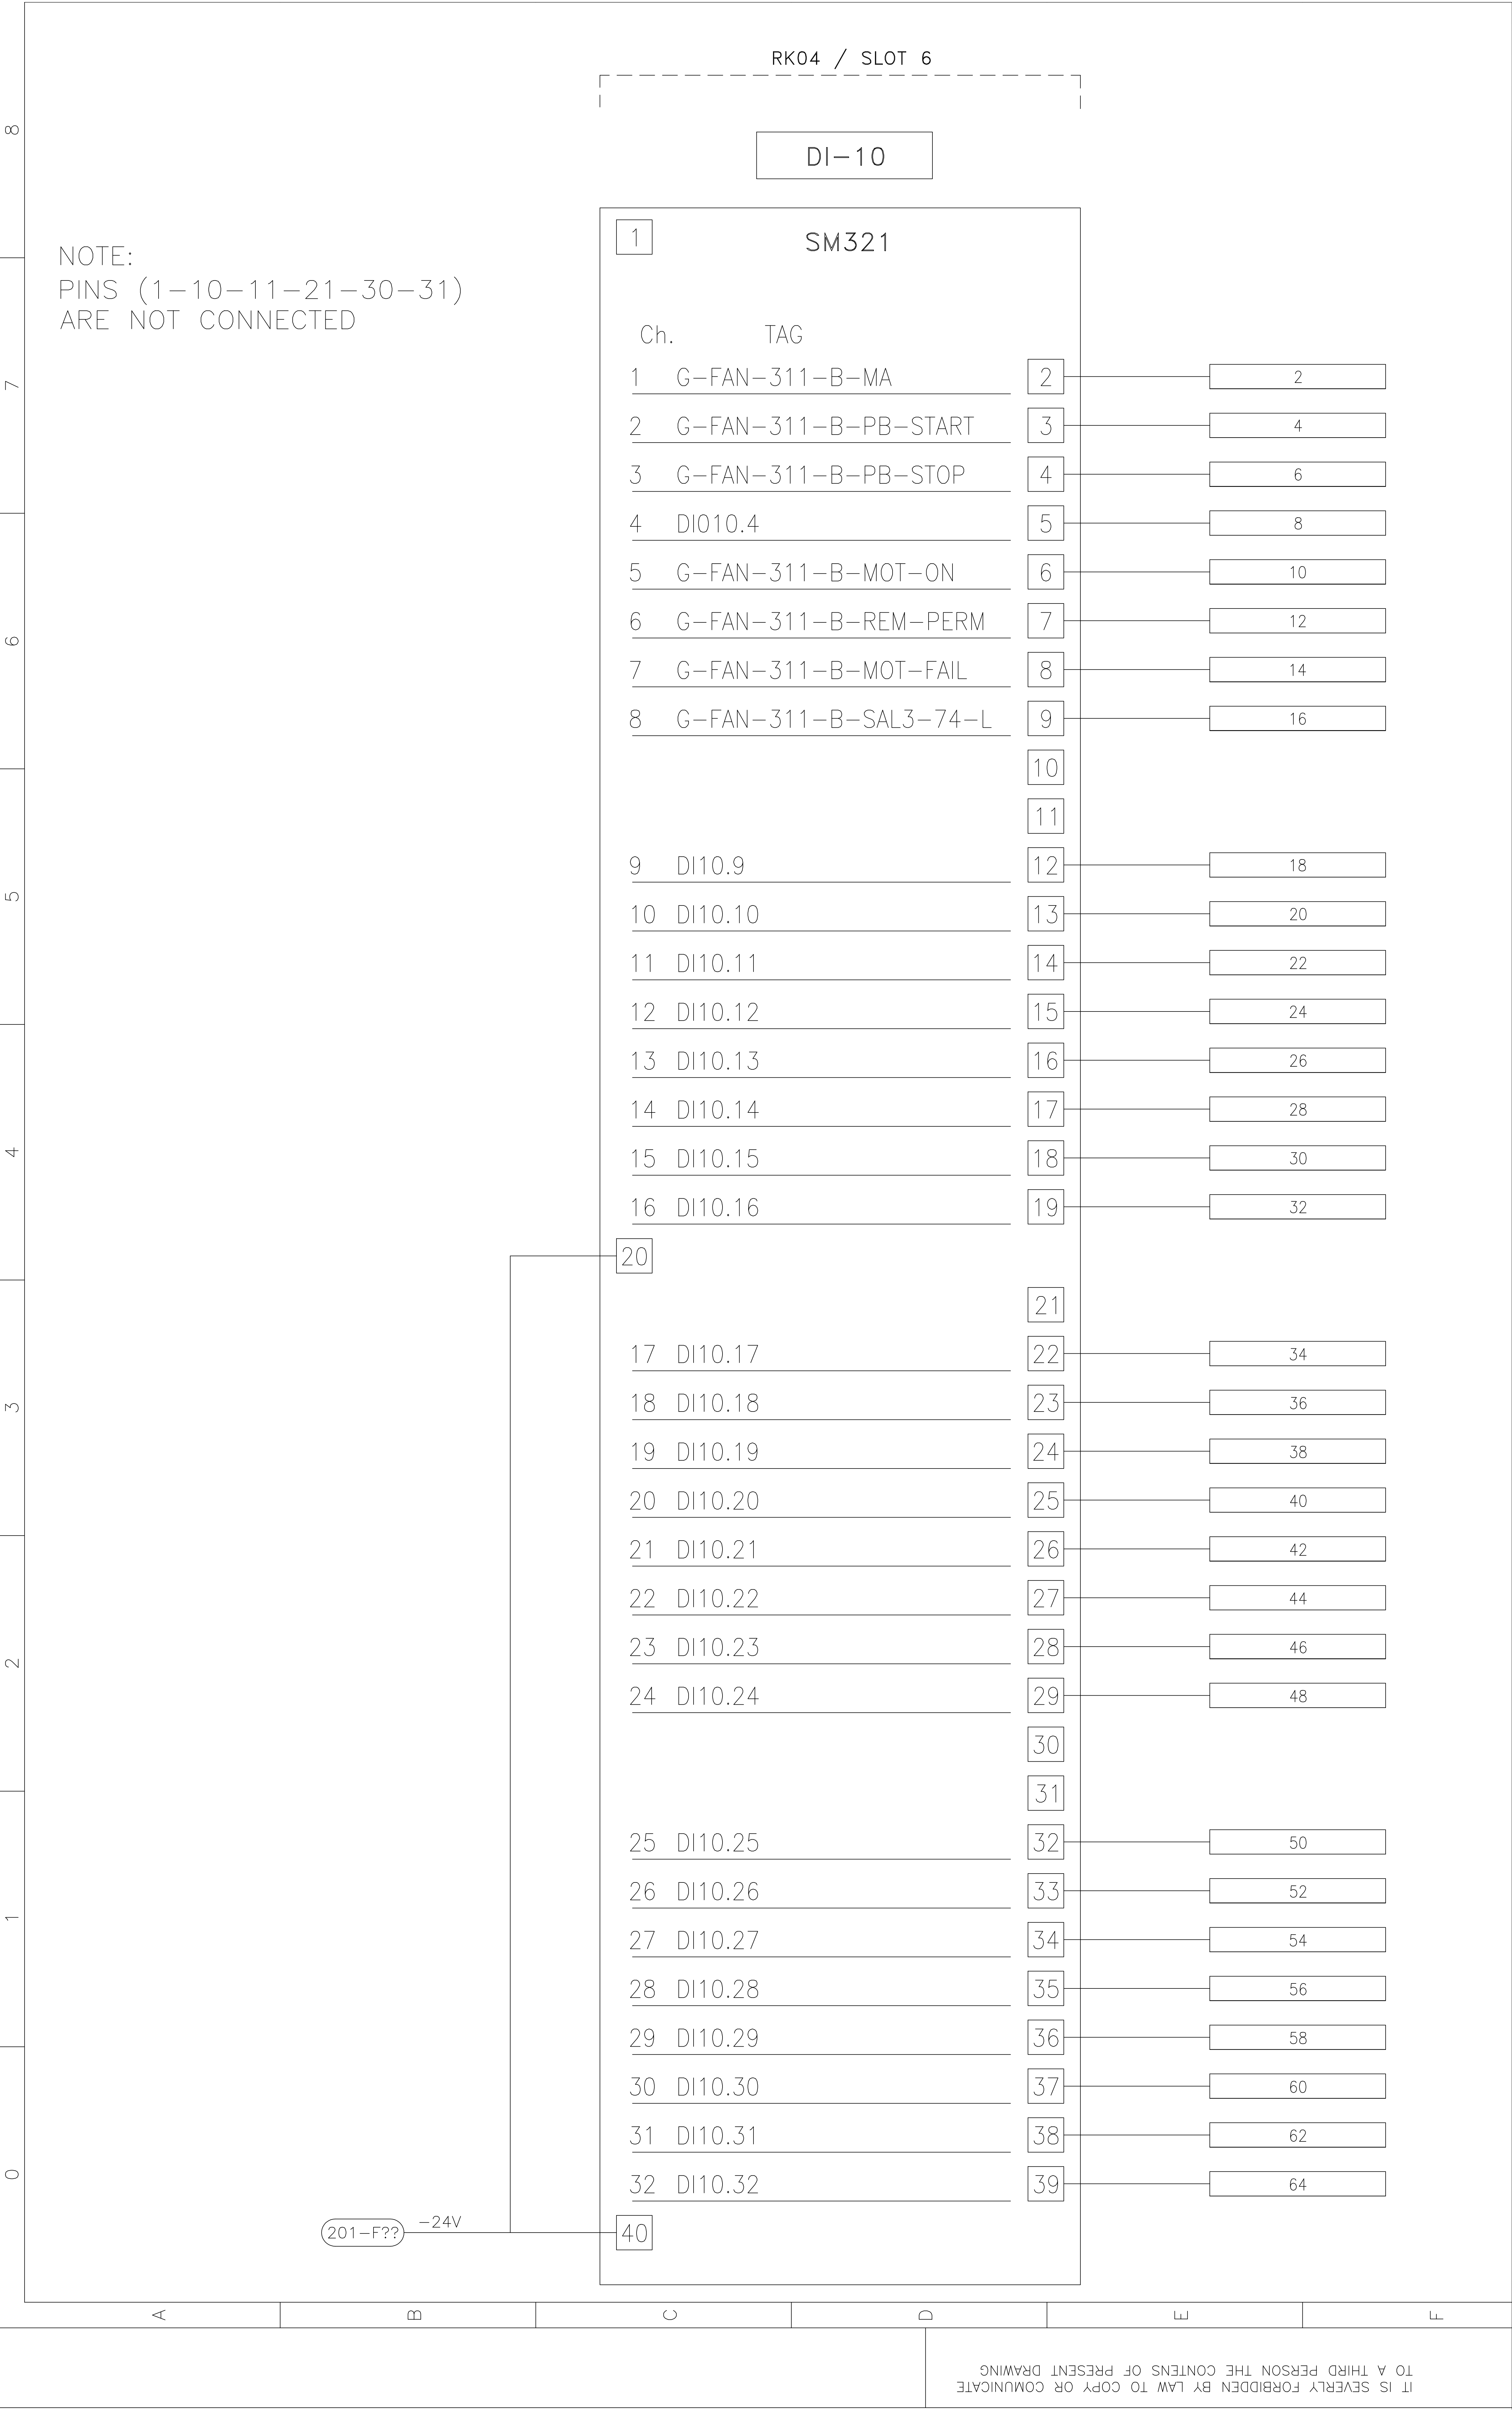

NOTE:

PINS (1-10-11-21-30-31)

ARE NOT CONNECTED

RK04 / SLOT 6

DI-10

1

SM321

Ch.

TAG

1

G-FAN-311-B-MA

2

G-FAN-311-B-PB-START

3

G-FAN-311-B-PB-STOP

4

DI10.4

5

G-FAN-311-B-MOT-ON

6

G-FAN-311-B-REM-PERM

7

G-FAN-311-B-MOT-FAIL

8

G-FAN-311-B-SAL3-74-L

9

DI10.9

10

DI10.10

11

DI10.11

12

DI10.12

13

DI10.13

14

DI10.14

15

DI10.15

16

DI10.16

17

DI10.17

18

DI10.18

19

DI10.19

20

DI10.20

21

DI10.21

22

DI10.22

23

DI10.23

24

DI10.24

25

DI10.25

26

DI10.26

27

DI10.27

28

DI10.28

29

DI10.29

30

DI10.30

31

DI10.31

32

DI10.32

2

3

4

2

4

6

50

52

54

56

58

60

62

64


201-F??

-24V

20

40



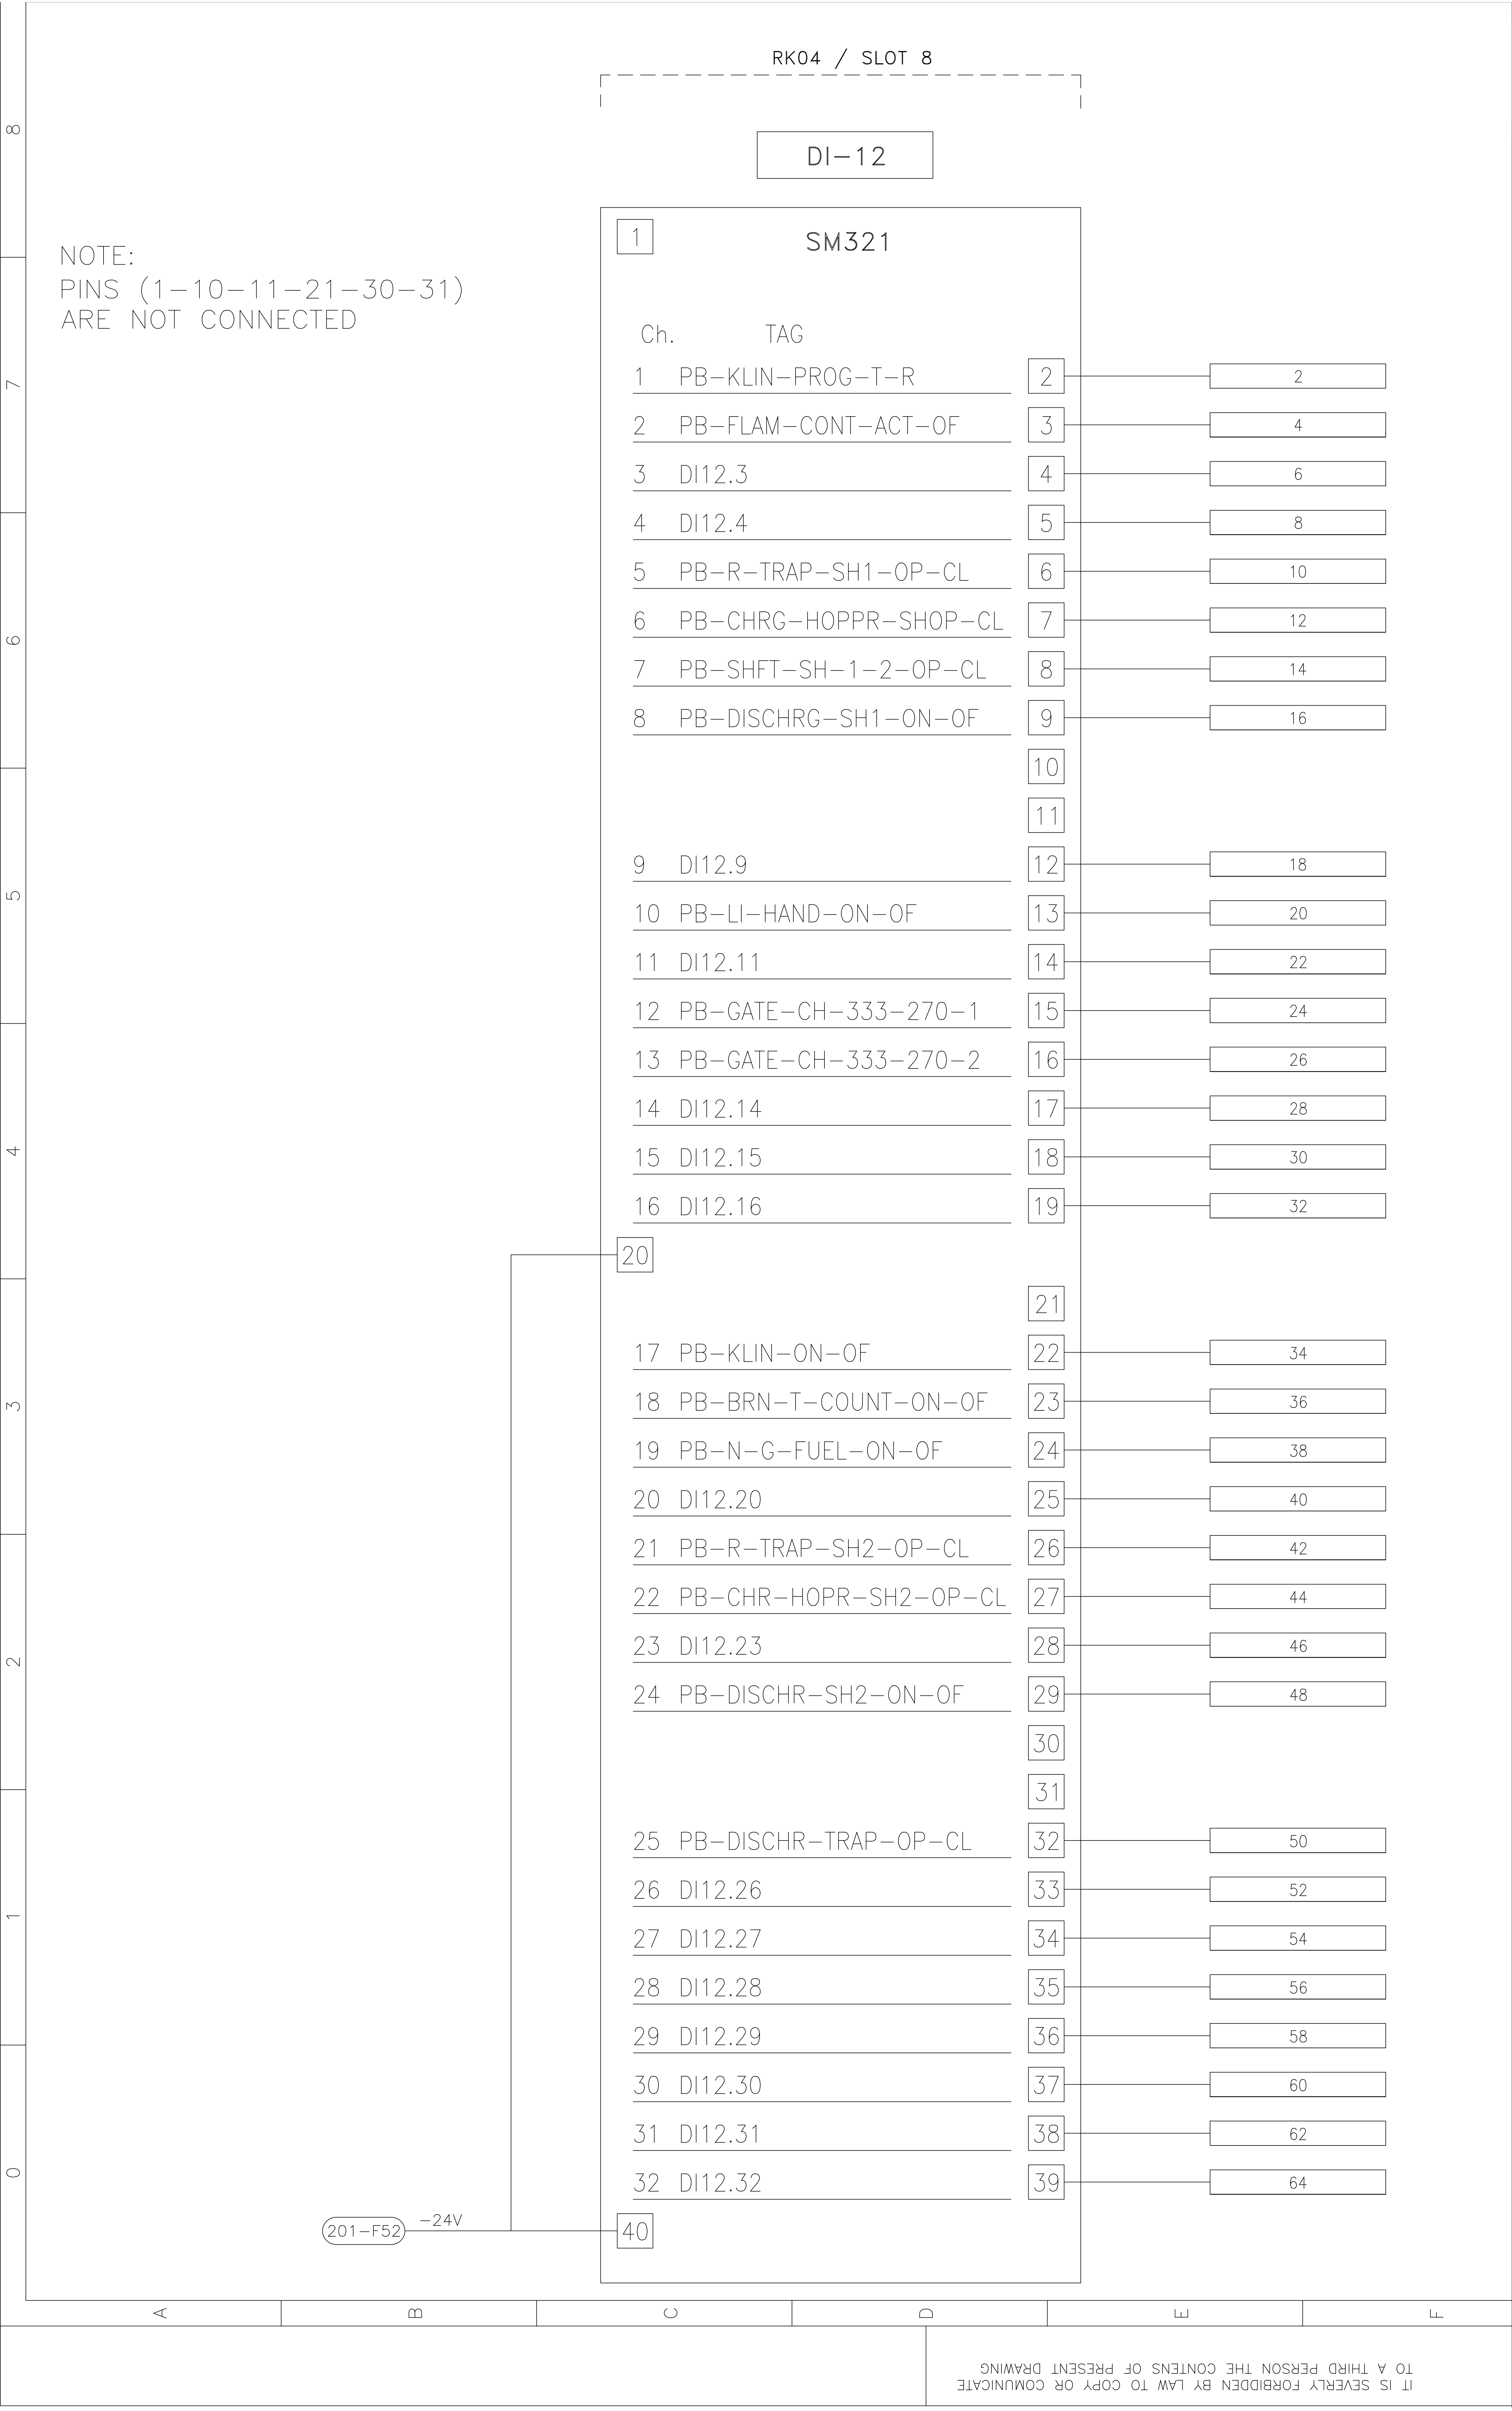

INTELISOFT

ORiSoft

Process Automation

NOTE

ASBUILT

PLANT LOCATION

ASCC ALEXANDRIA

SECTION

DI12 - DIGITAL INPUT WIRING DIAGRAM

DOC. TYPE

MAERZ - CABINET LAYOUT

CLIENT

ASCC

JOB

ID7854

DWG N.

ASCC_MRZ-2102

FILE NAME

ASCC_MRZ-2102-037

DATE

30/5/2006

REV

00

PREV


36

PAGE

37

NEX

38

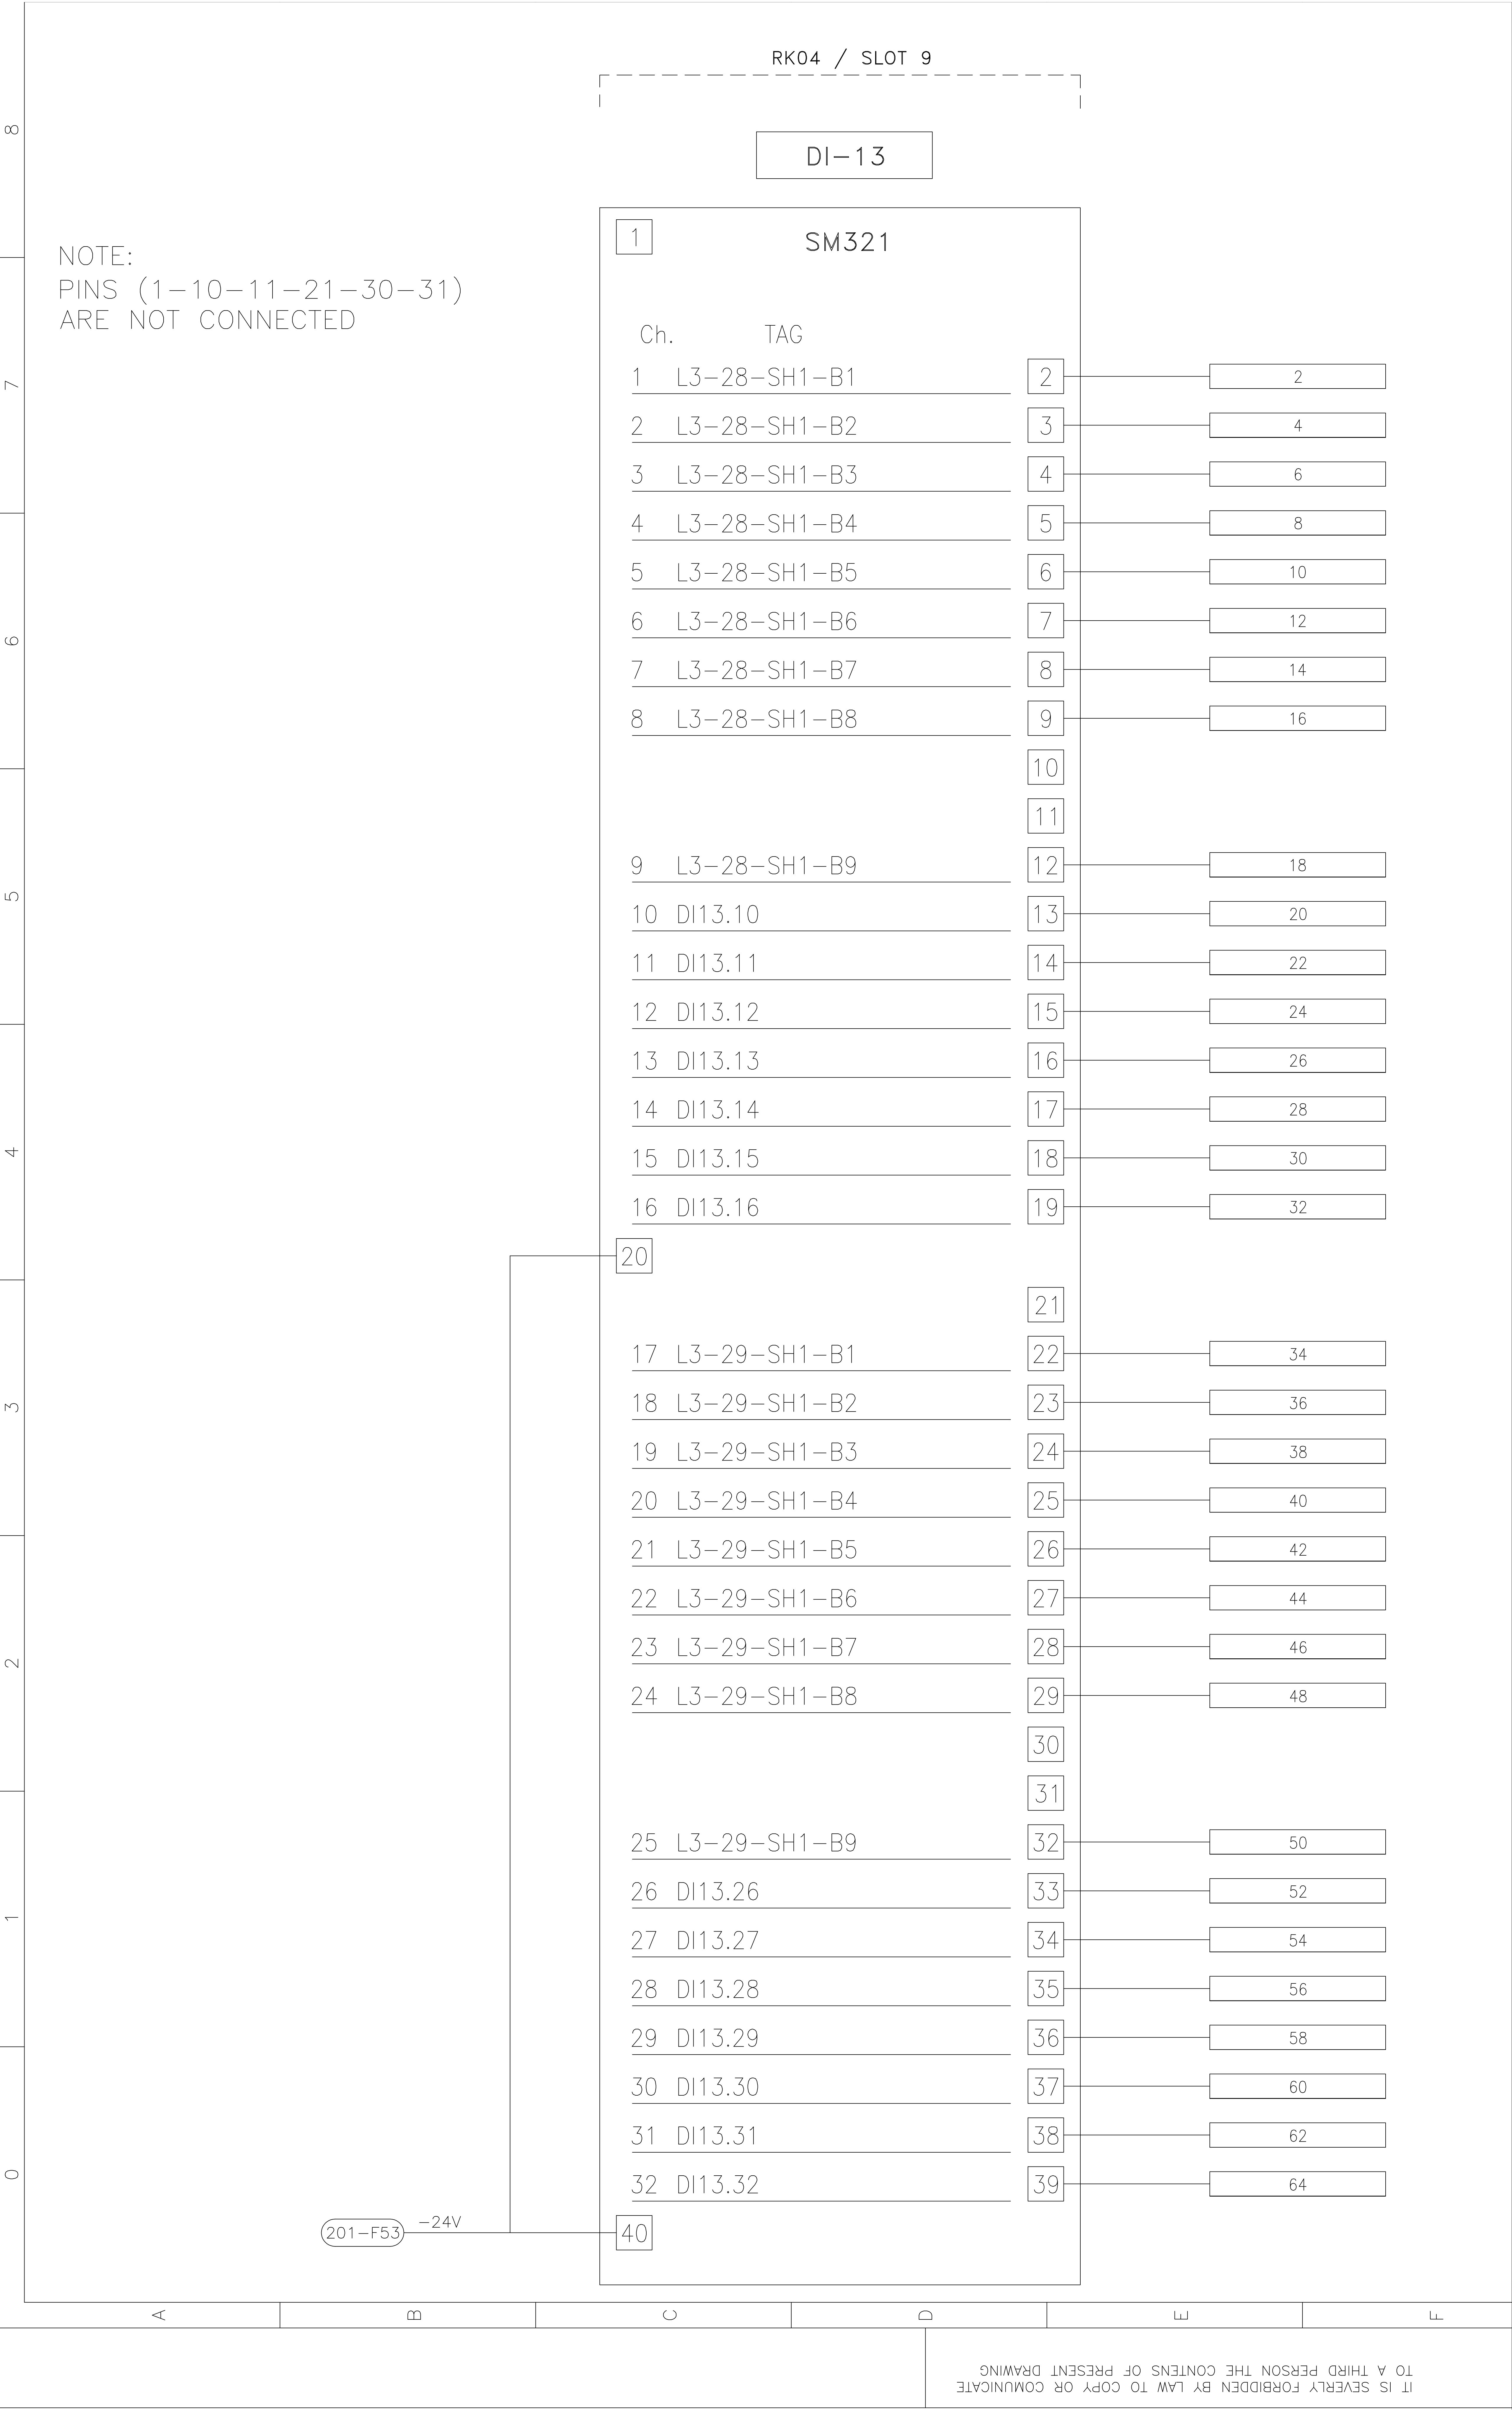

INTELISOFT

ORI

SOFT

Process Automation

NOTE

ASBUILT

PLANT LOCATION

SECTION

DOC. TYPE

ASCC ALEXANDRIA

DI13 - DIGITAL INPUT WIRING DIAGRAM

MAERZ - CABINET LAYOUT

CLIENT

ASCC

JOB

DWG N.

FILE NAME

DATE

REV

PREV

PAGE

NEX

4:

ID7854

ASCC_MRZ-2102

ASCC_MRZ-2102-038


30/5/2006


00


37


38

4:

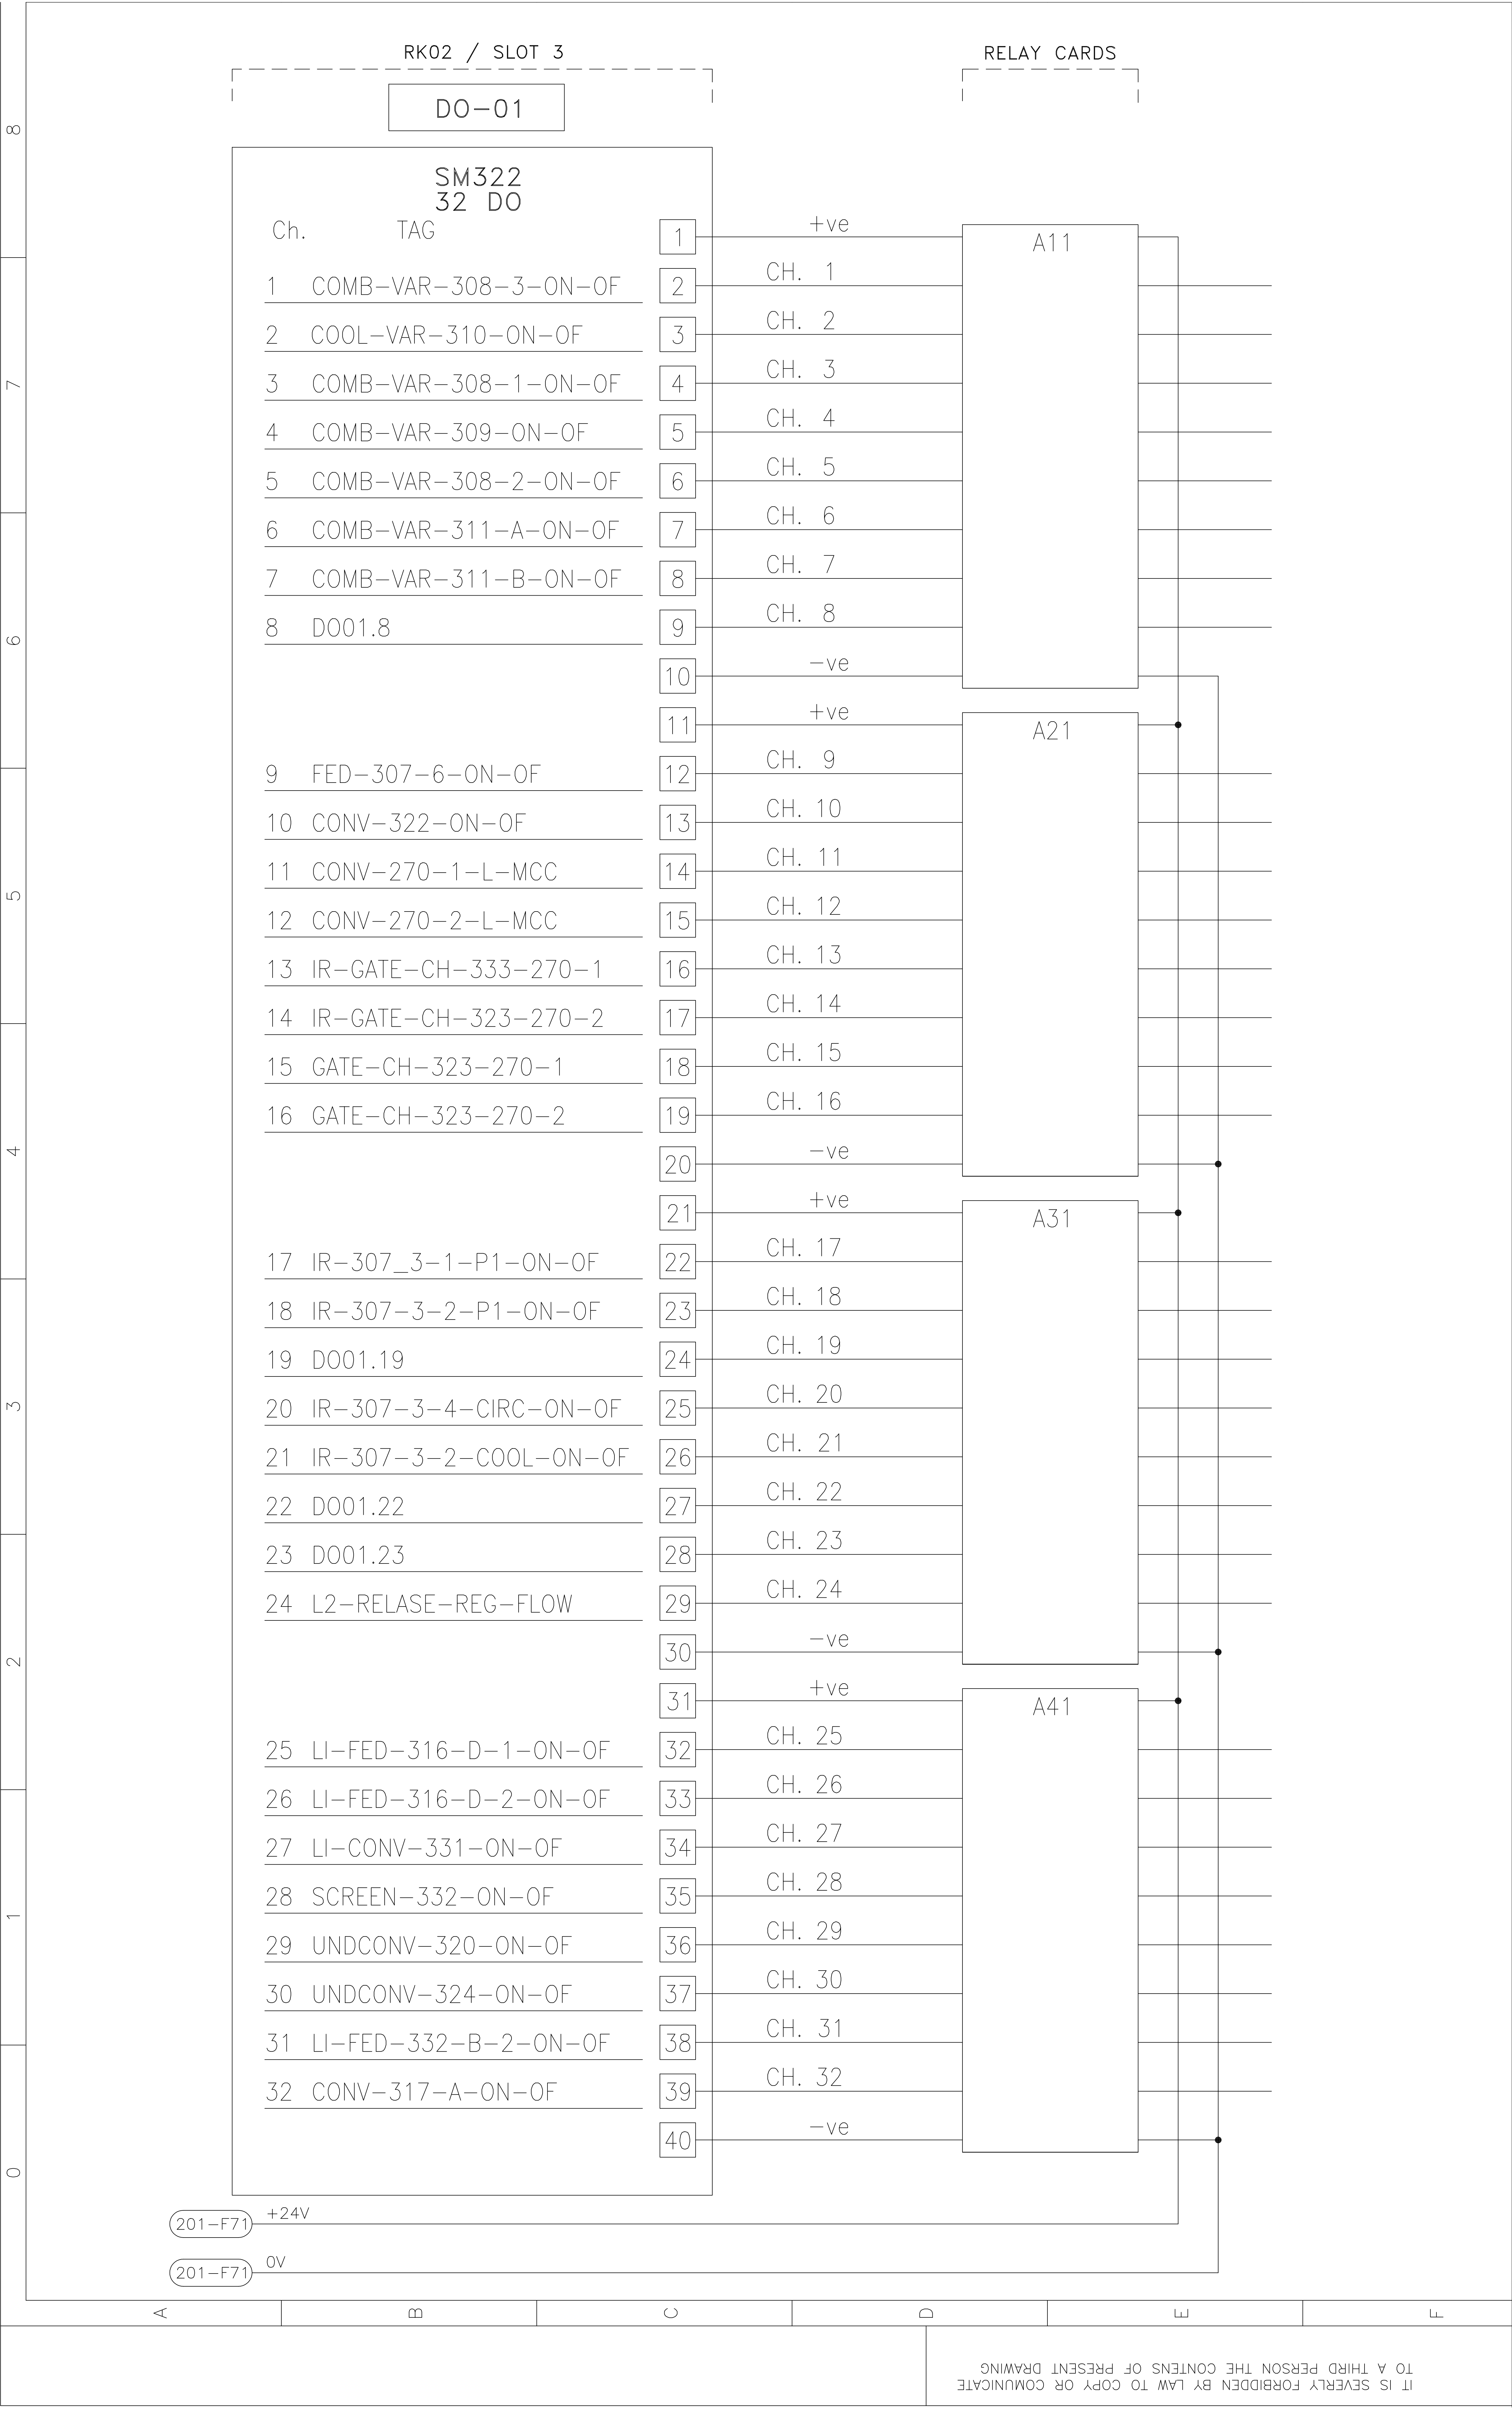


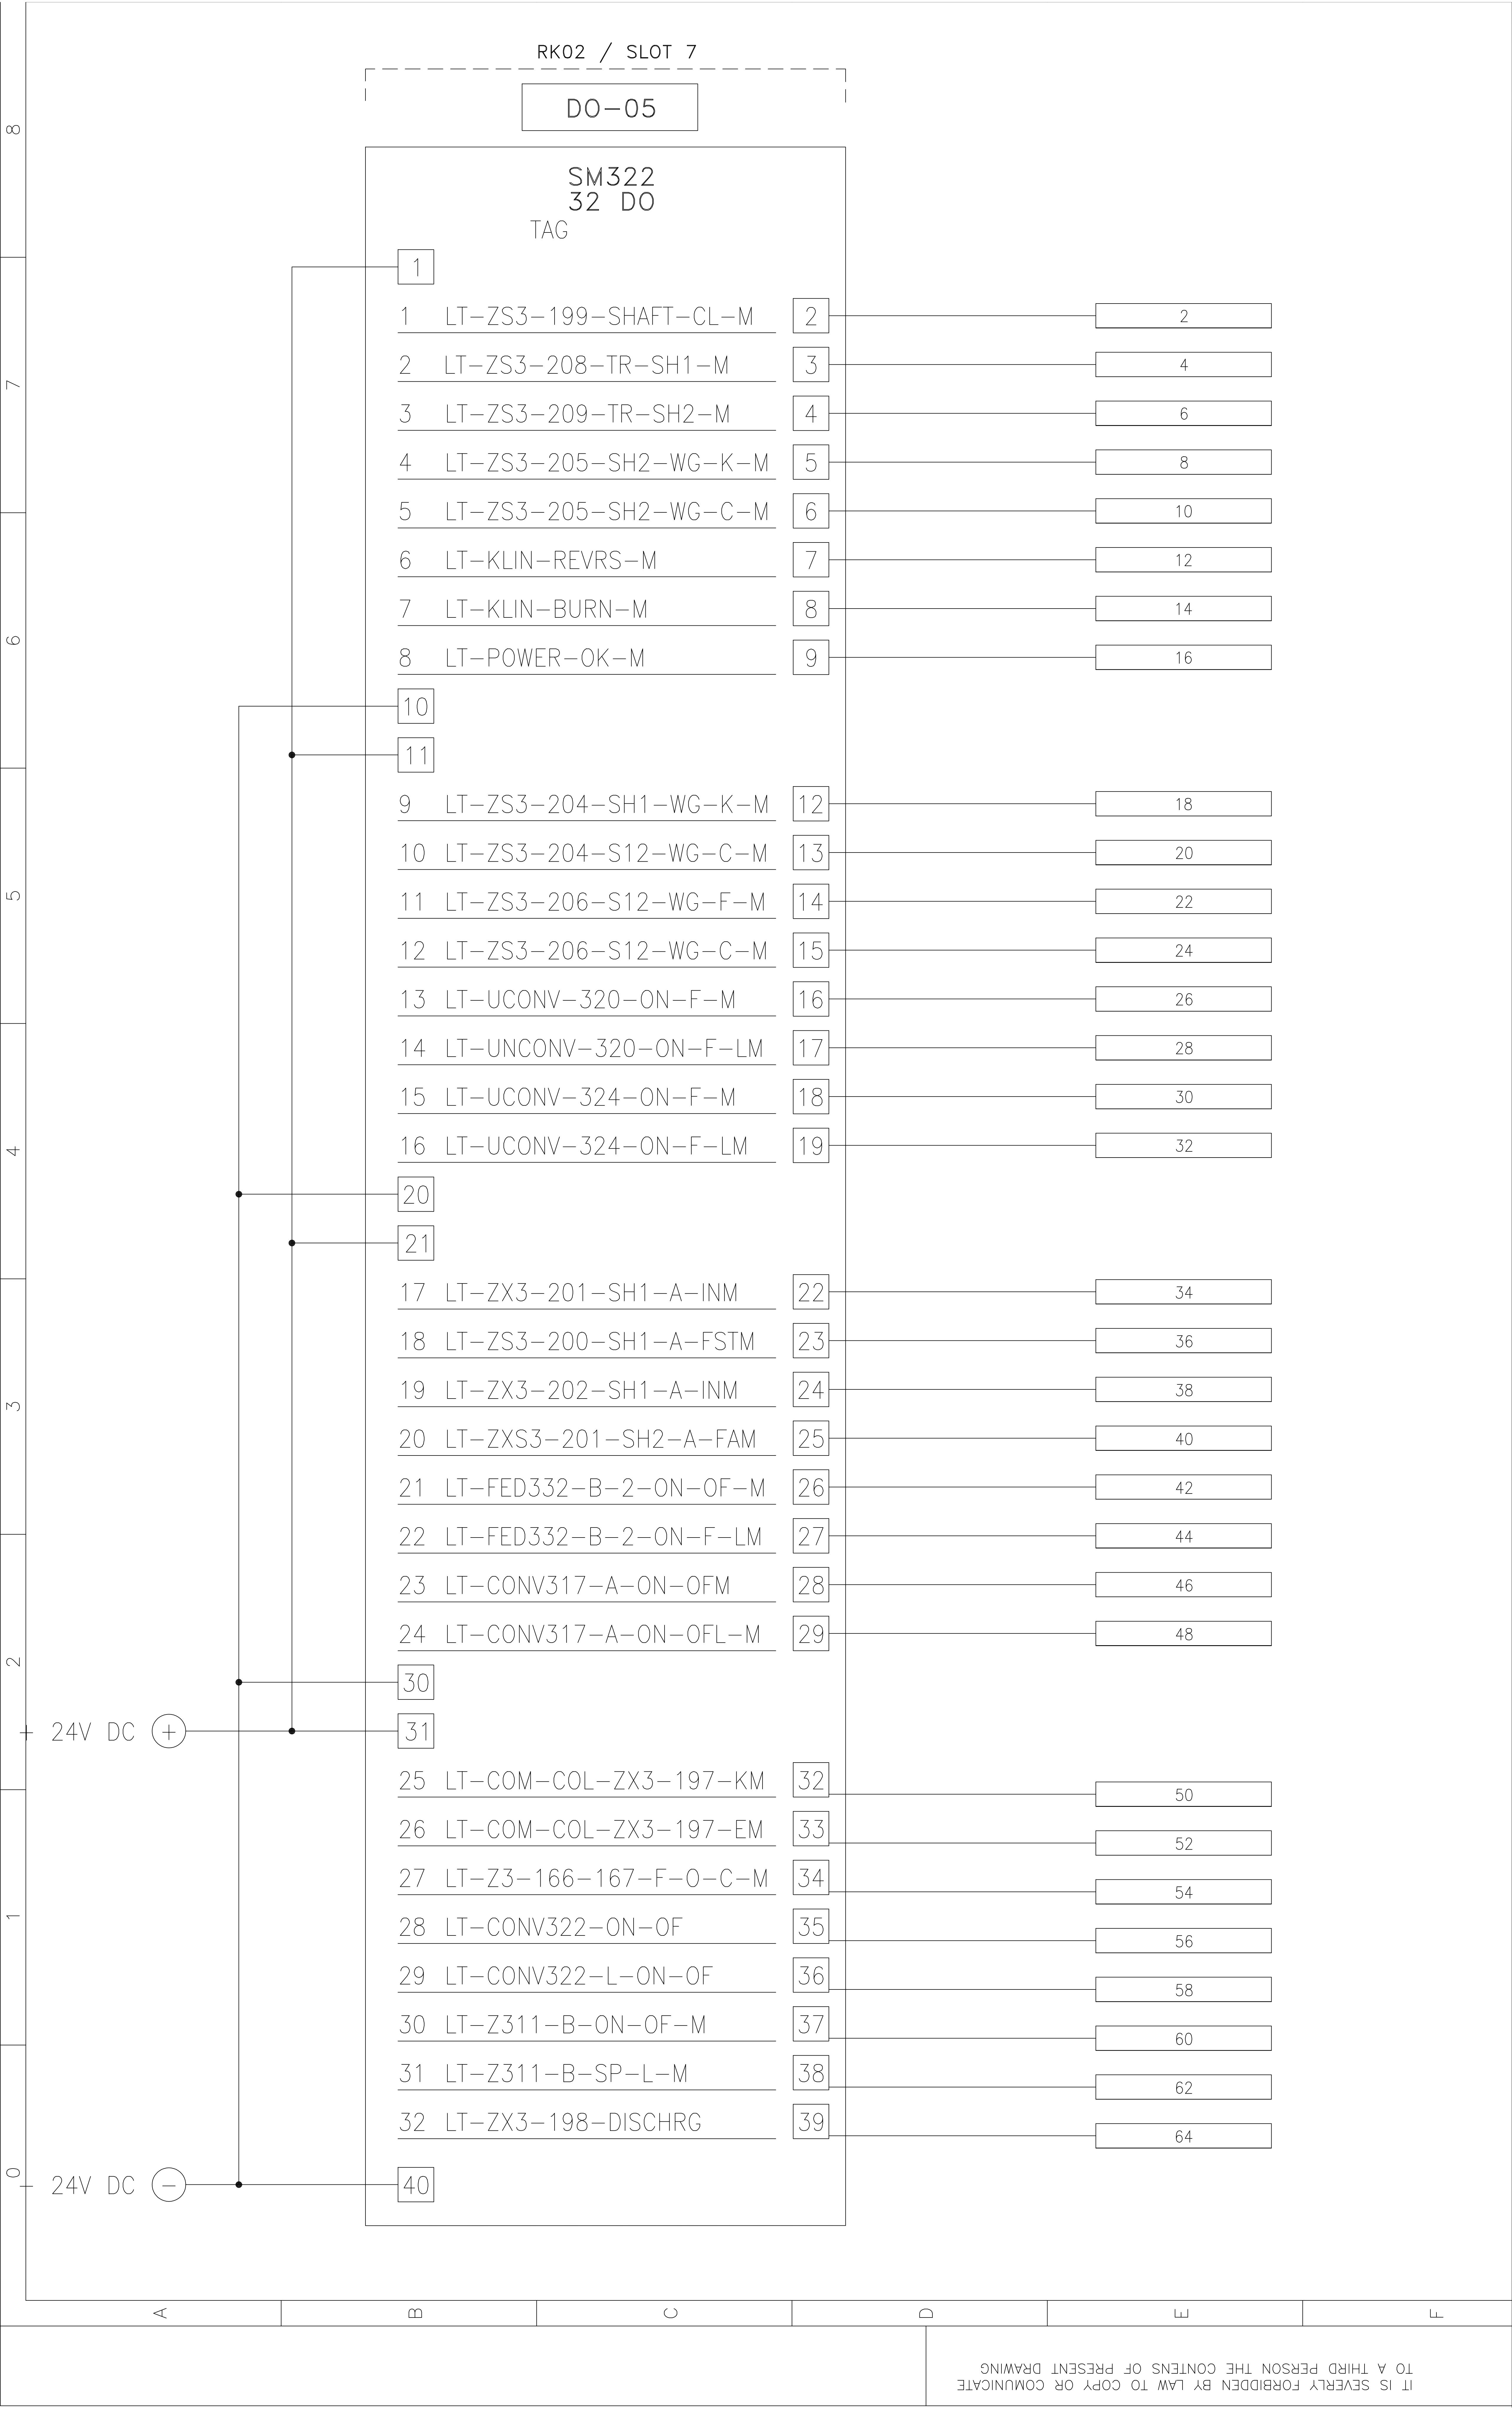

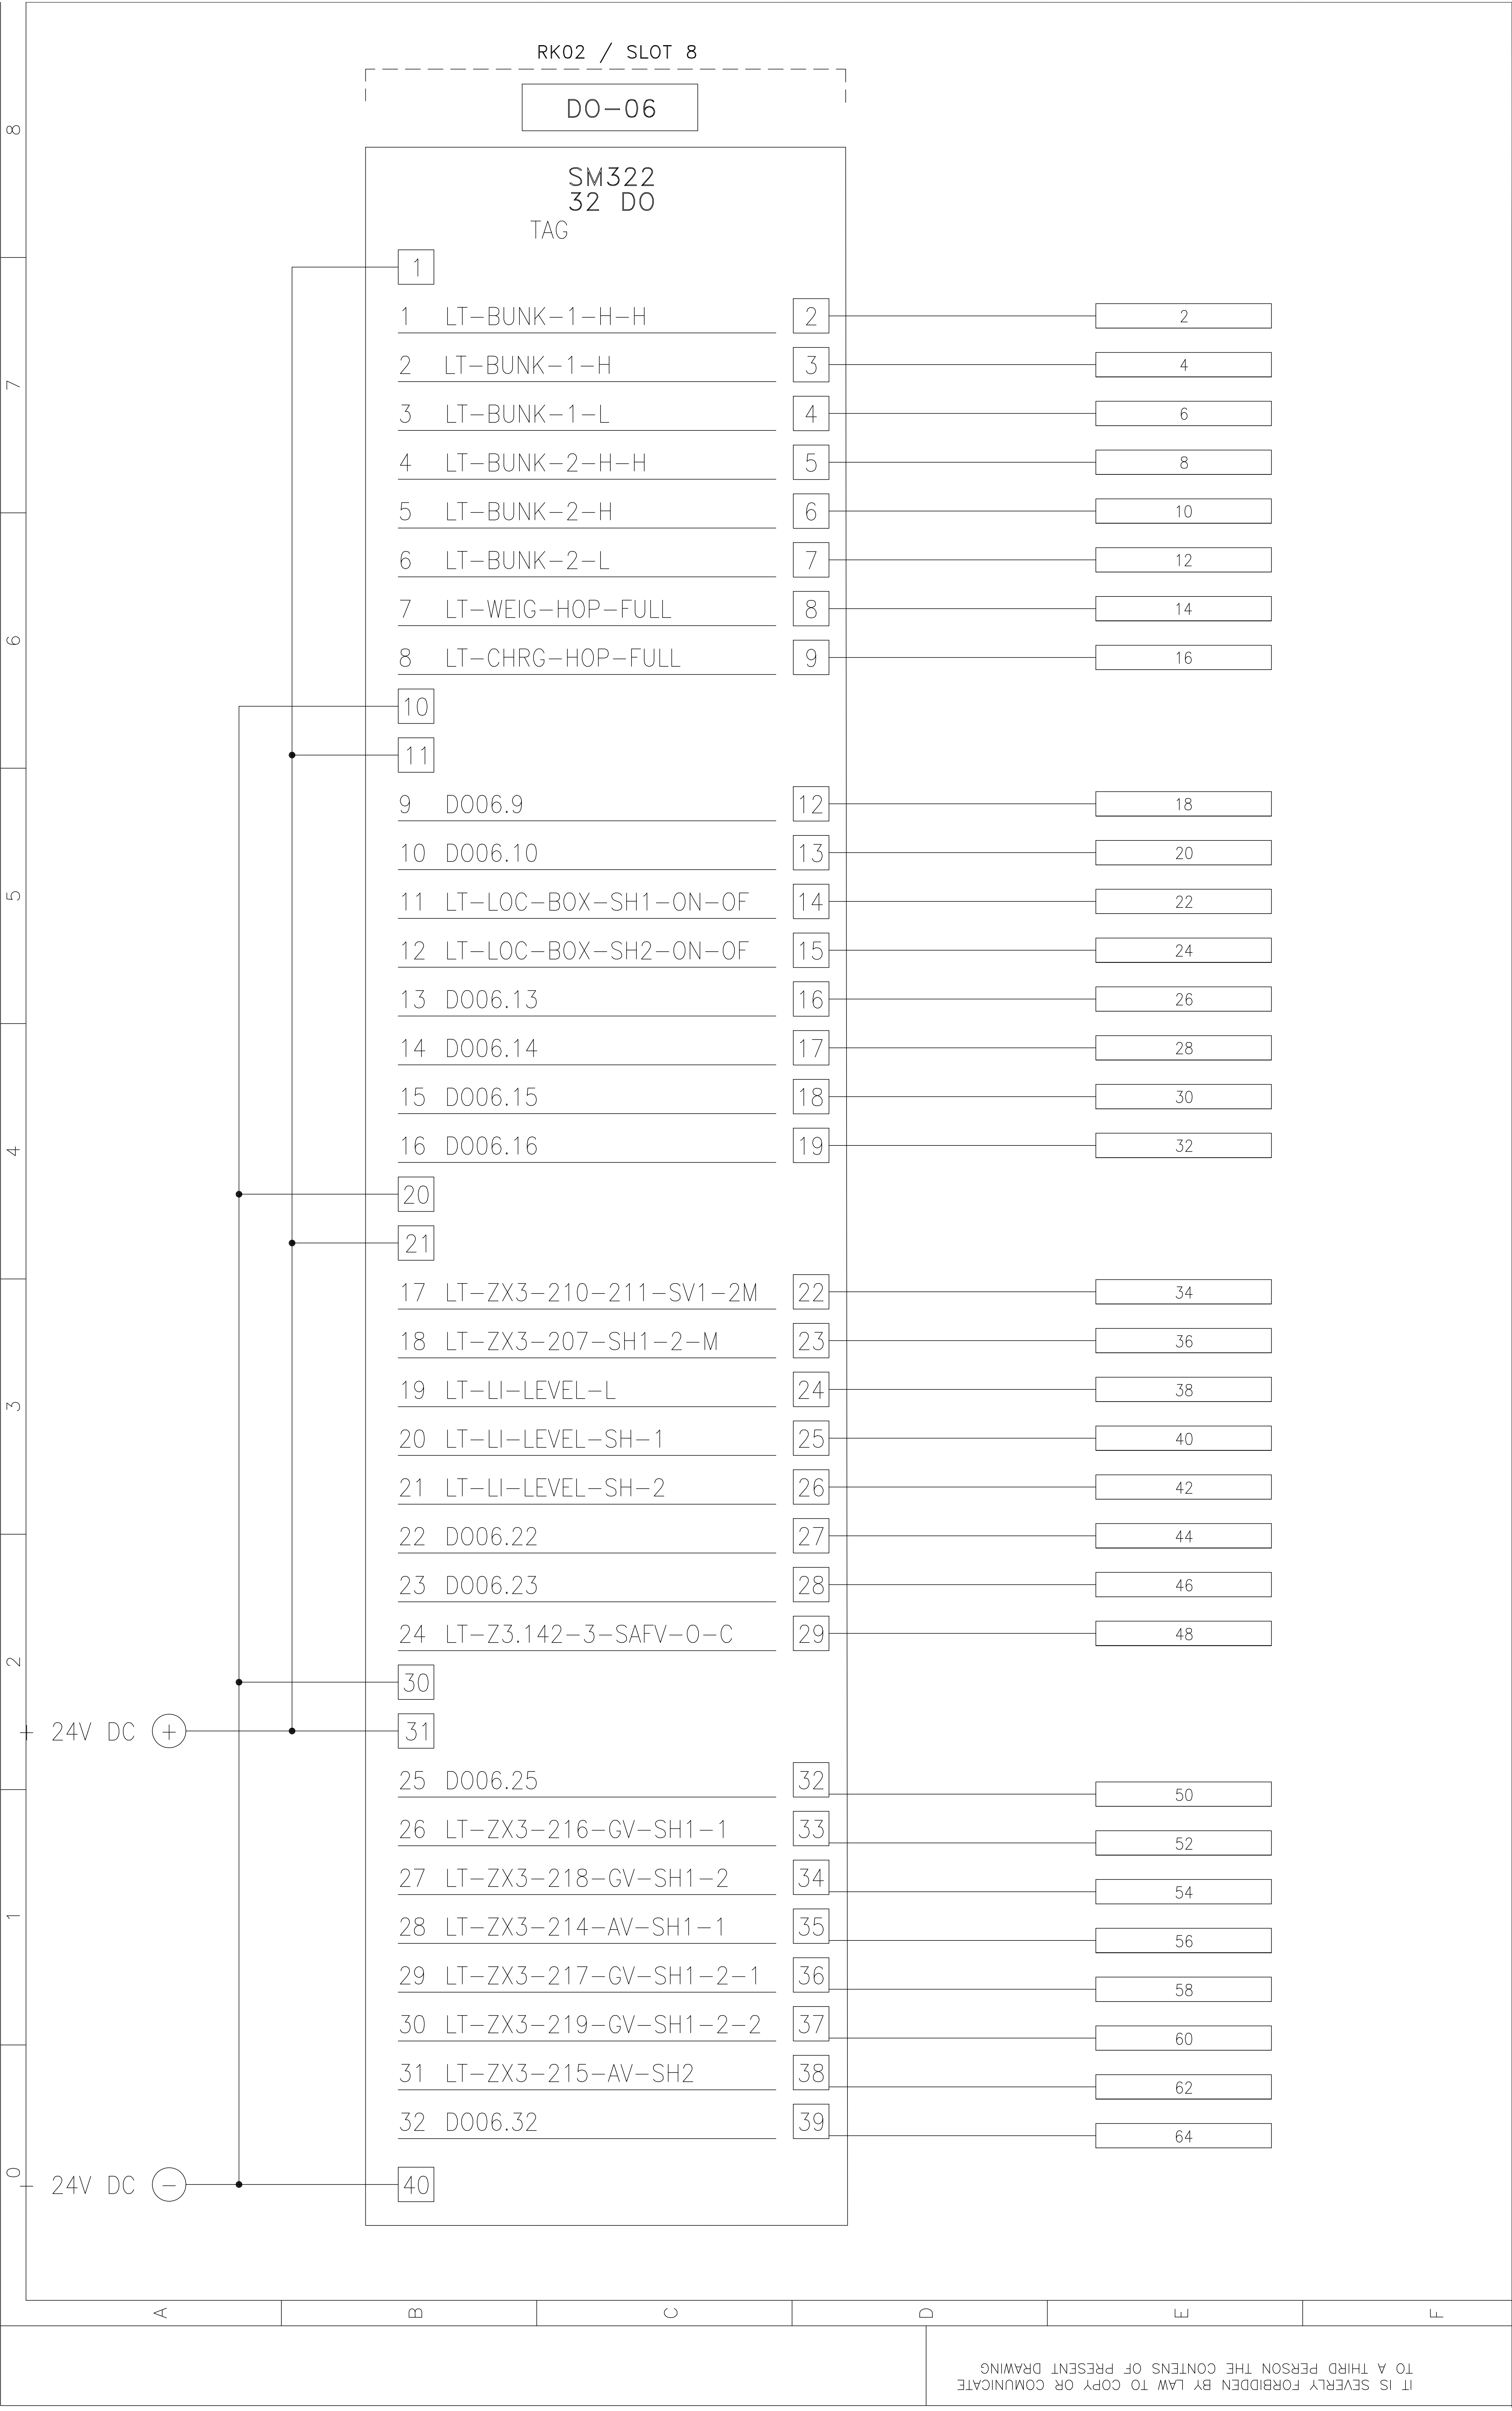

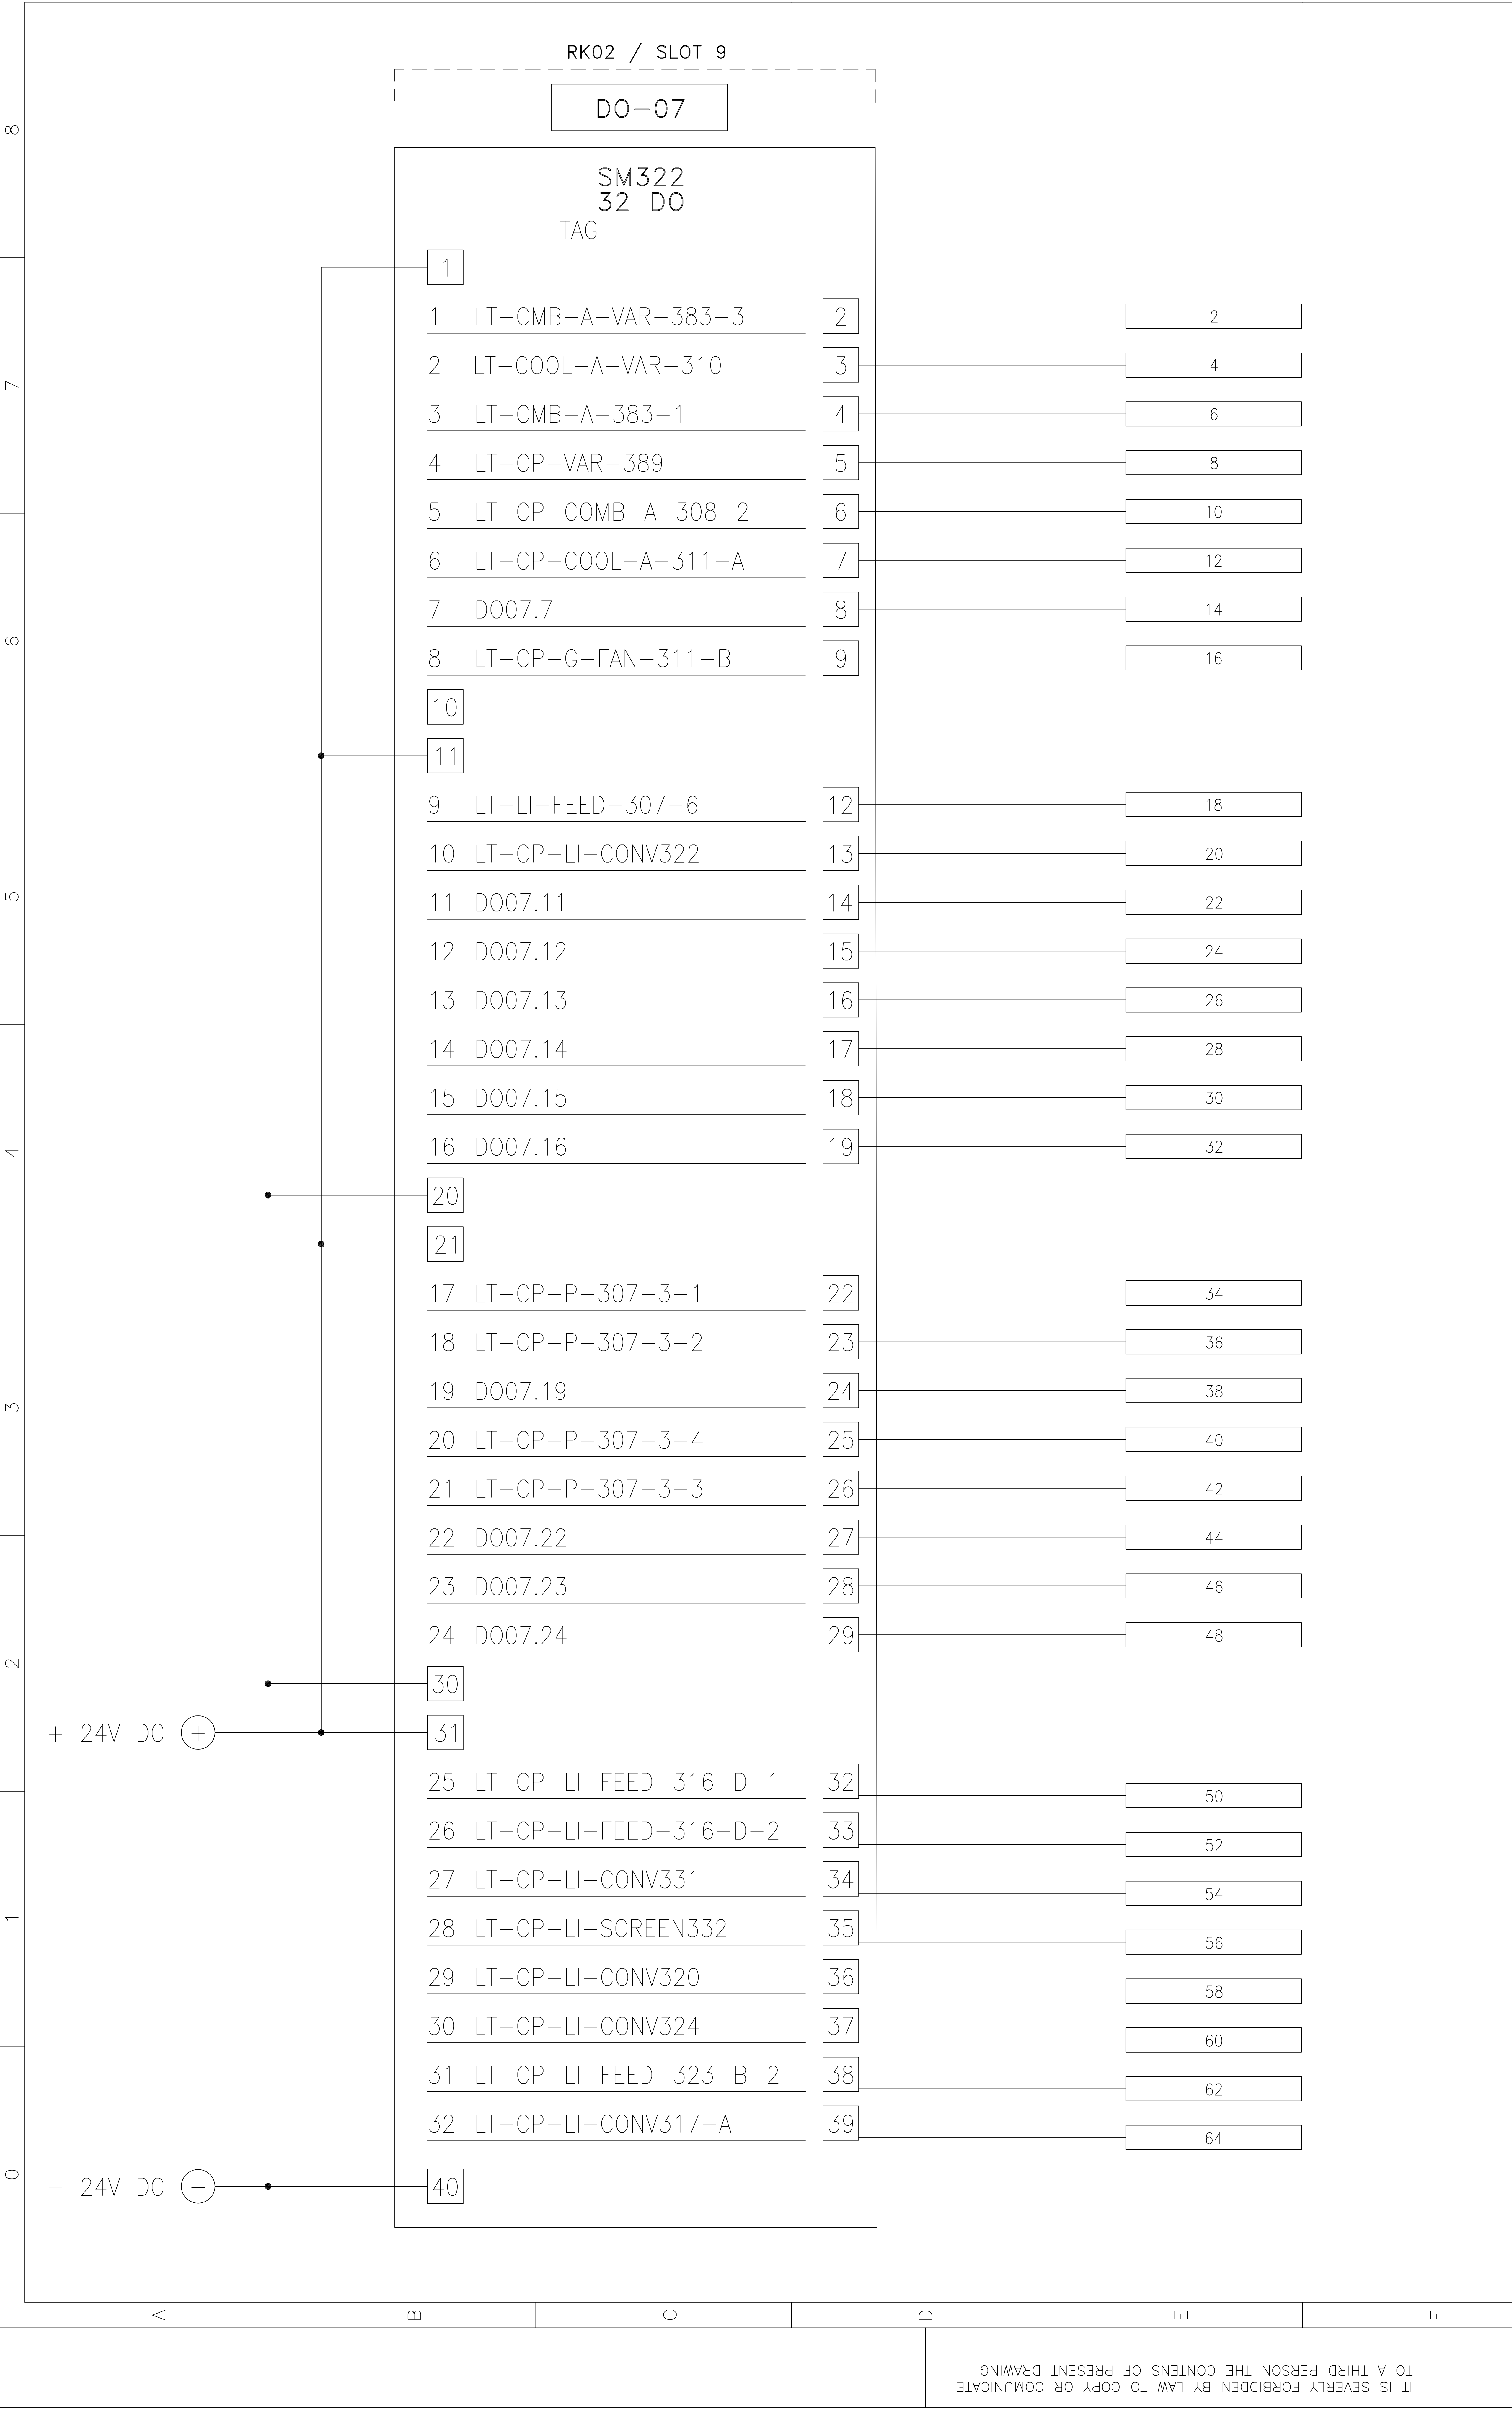

INTELISOFT

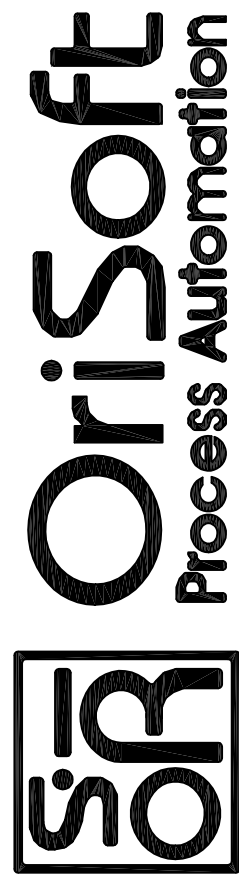

NOTE

ASBUILT

PLANT LOCATION

SECTION

DOC. TYPE

ASCC ALEXANDRIA

D007 – DIGITAL OUTPUT WIRING DIAGRAM

MAERZ – CABINET LAYOUT

CLIENT

ASCC

JOB

DWG N.

FILE NAME

DATE

REV

PREV

NEX

ID7854

ASCC_MRZ-2102

ASCC_MRZ-2102-049


30/5/2006

00


48

49


50

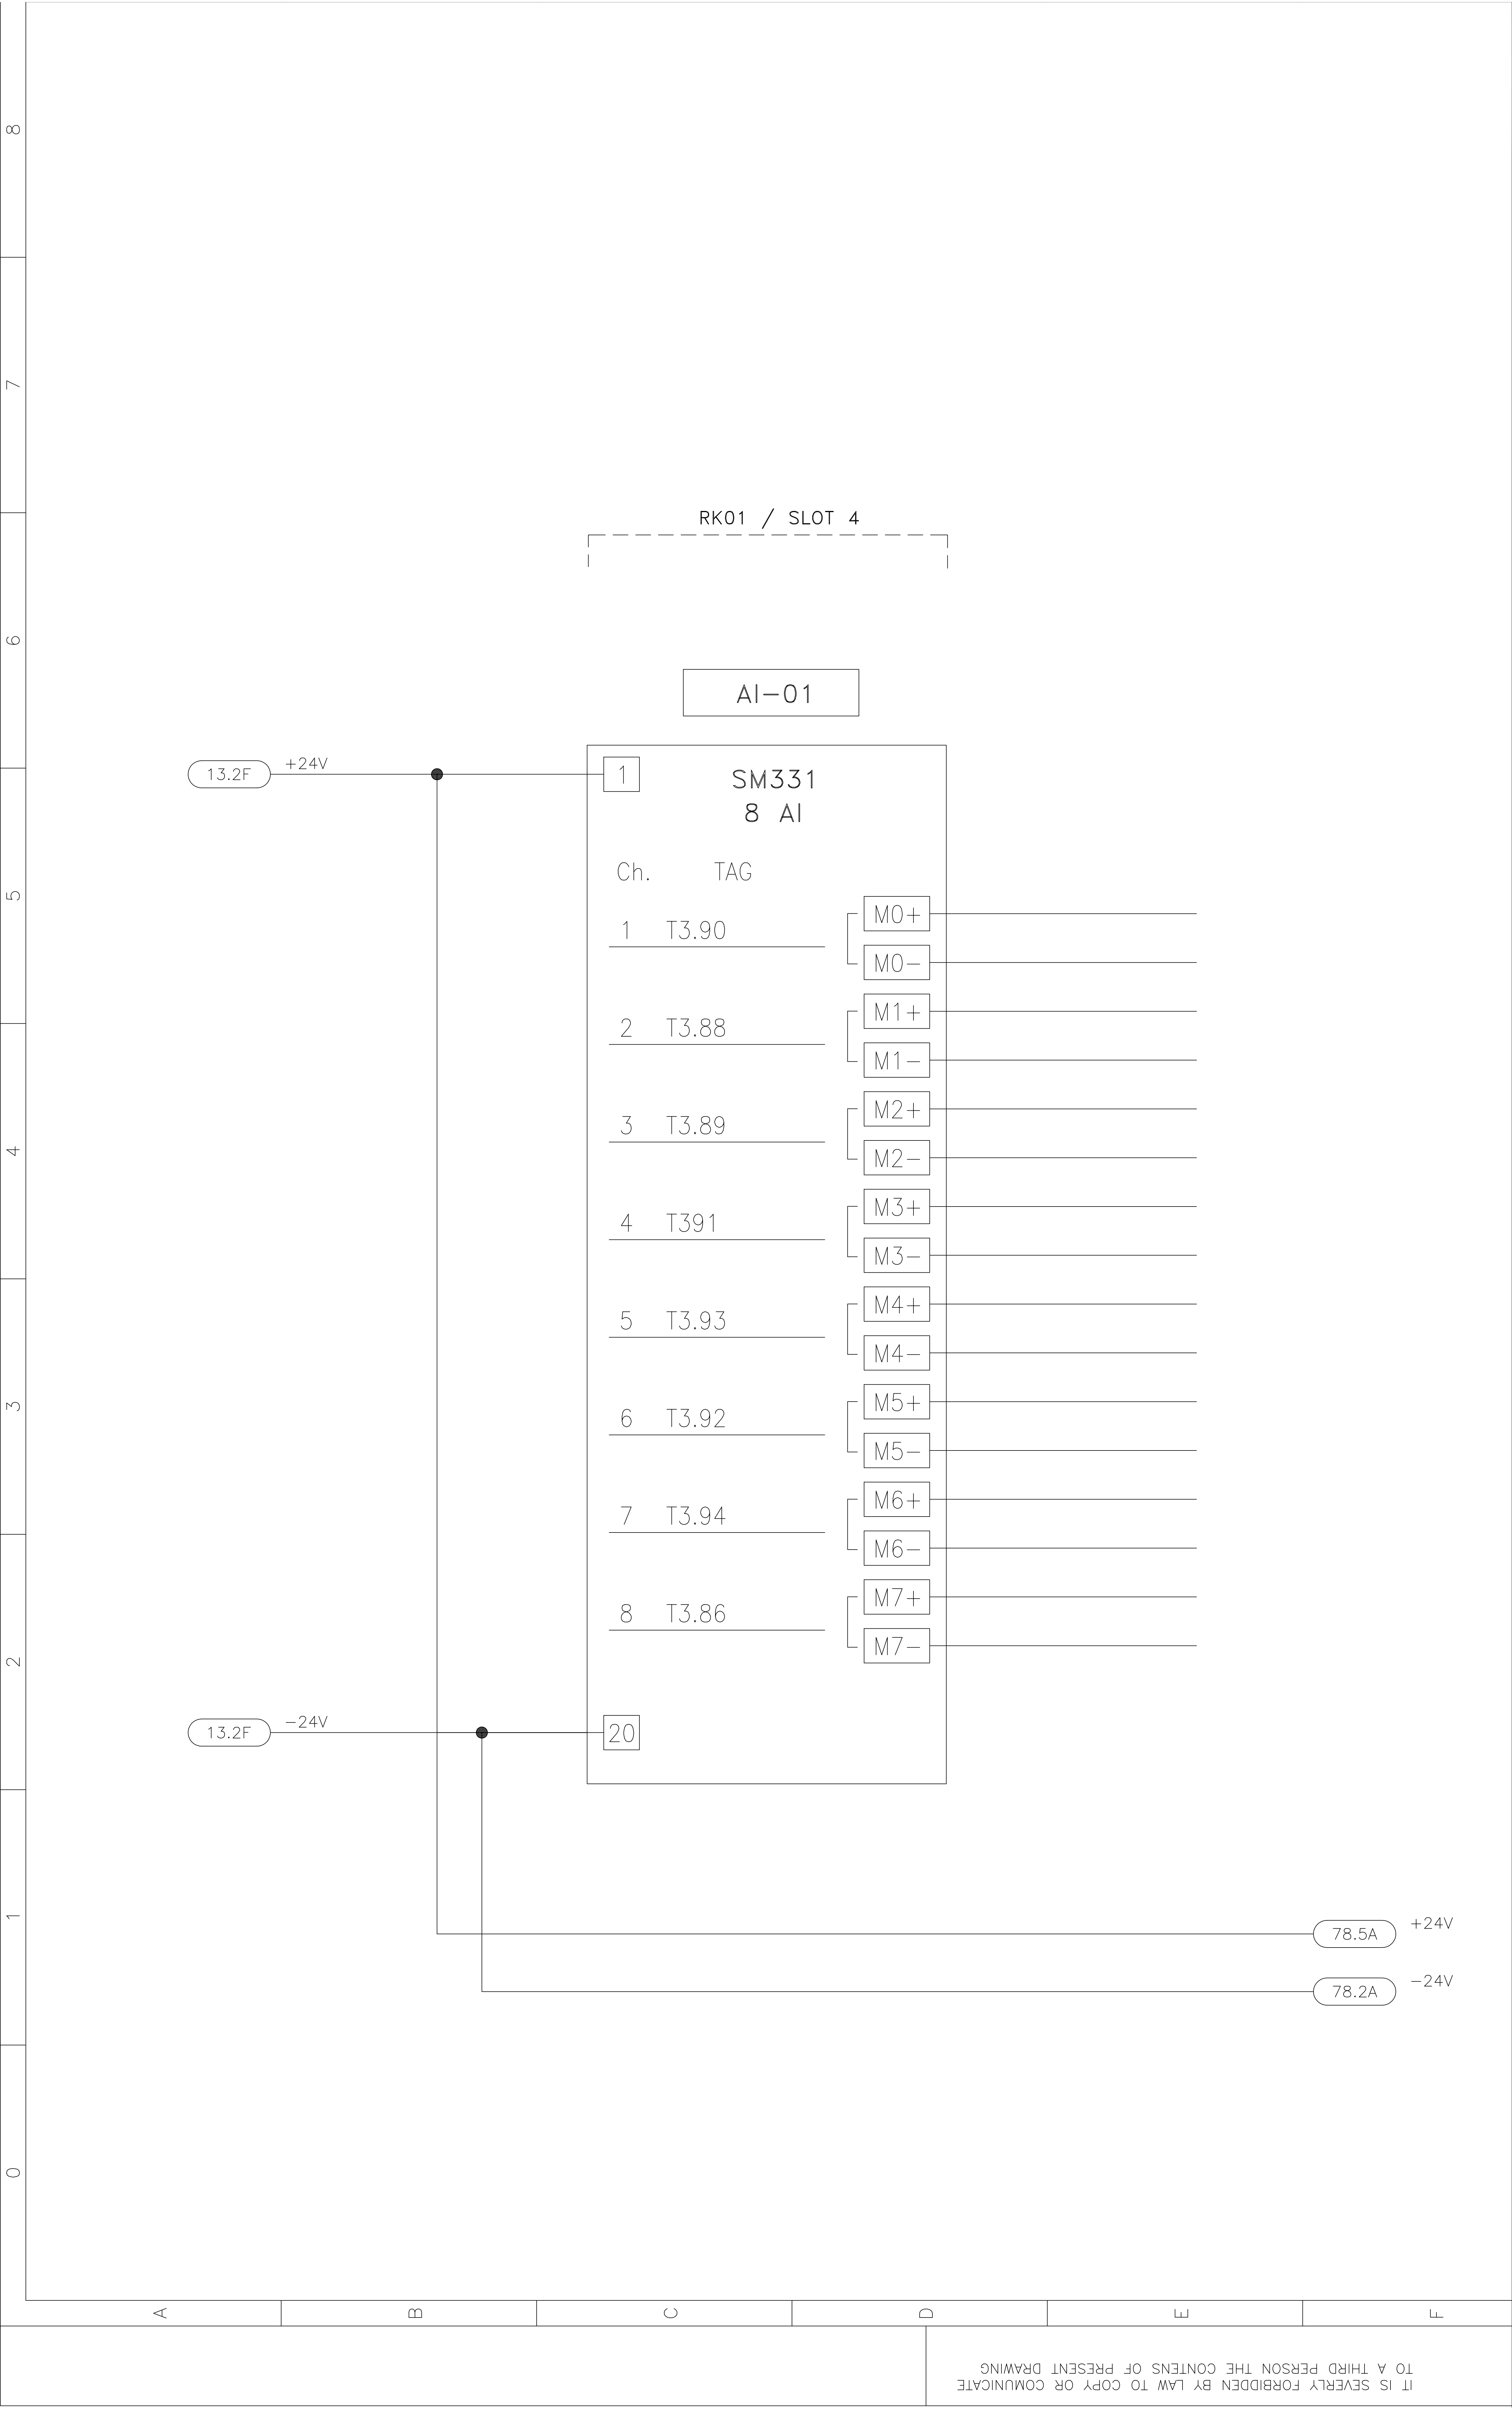

PLANT LOCATION		ASCC ALEXANDRIA		JOB		ID7854	
SECTION		AI01 – ANALOG INPUT WIRING DIAGRAM		DWG N.		ASCC_MRZ-2102	
DOC. TYPE		MAERZ – CABINET LAYOUT		FILE NAME		ASCC_MRZ-2102-076	
NOTE		ASBUILT		DATE		REV	PREV
				30/5/2006		00	51
						PAGE	NEX
						76	78

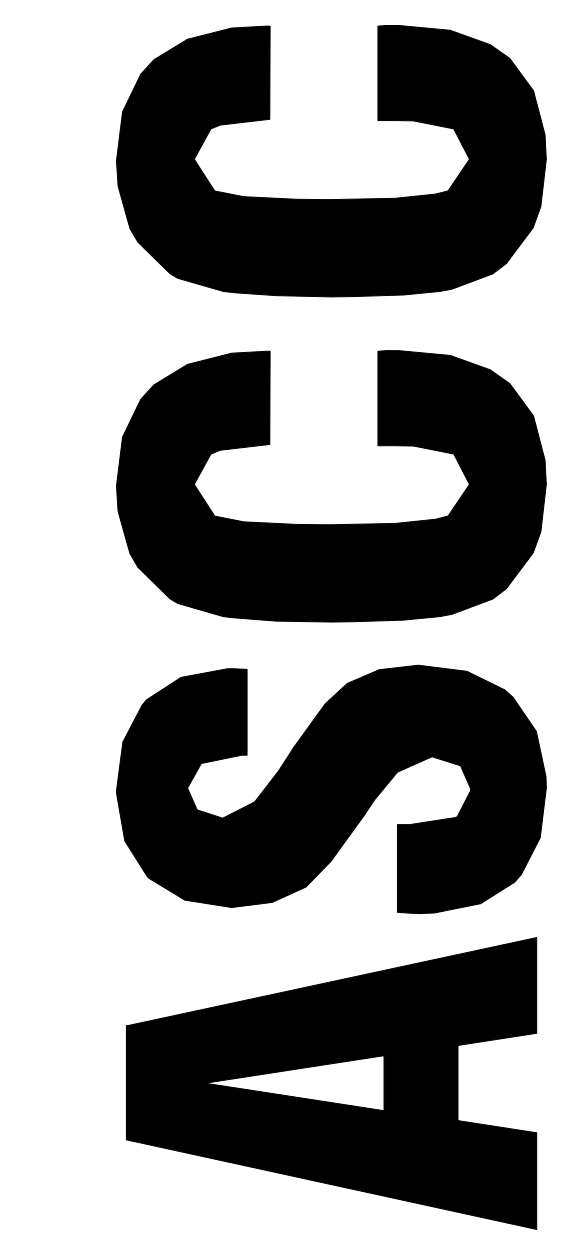

CLIENT

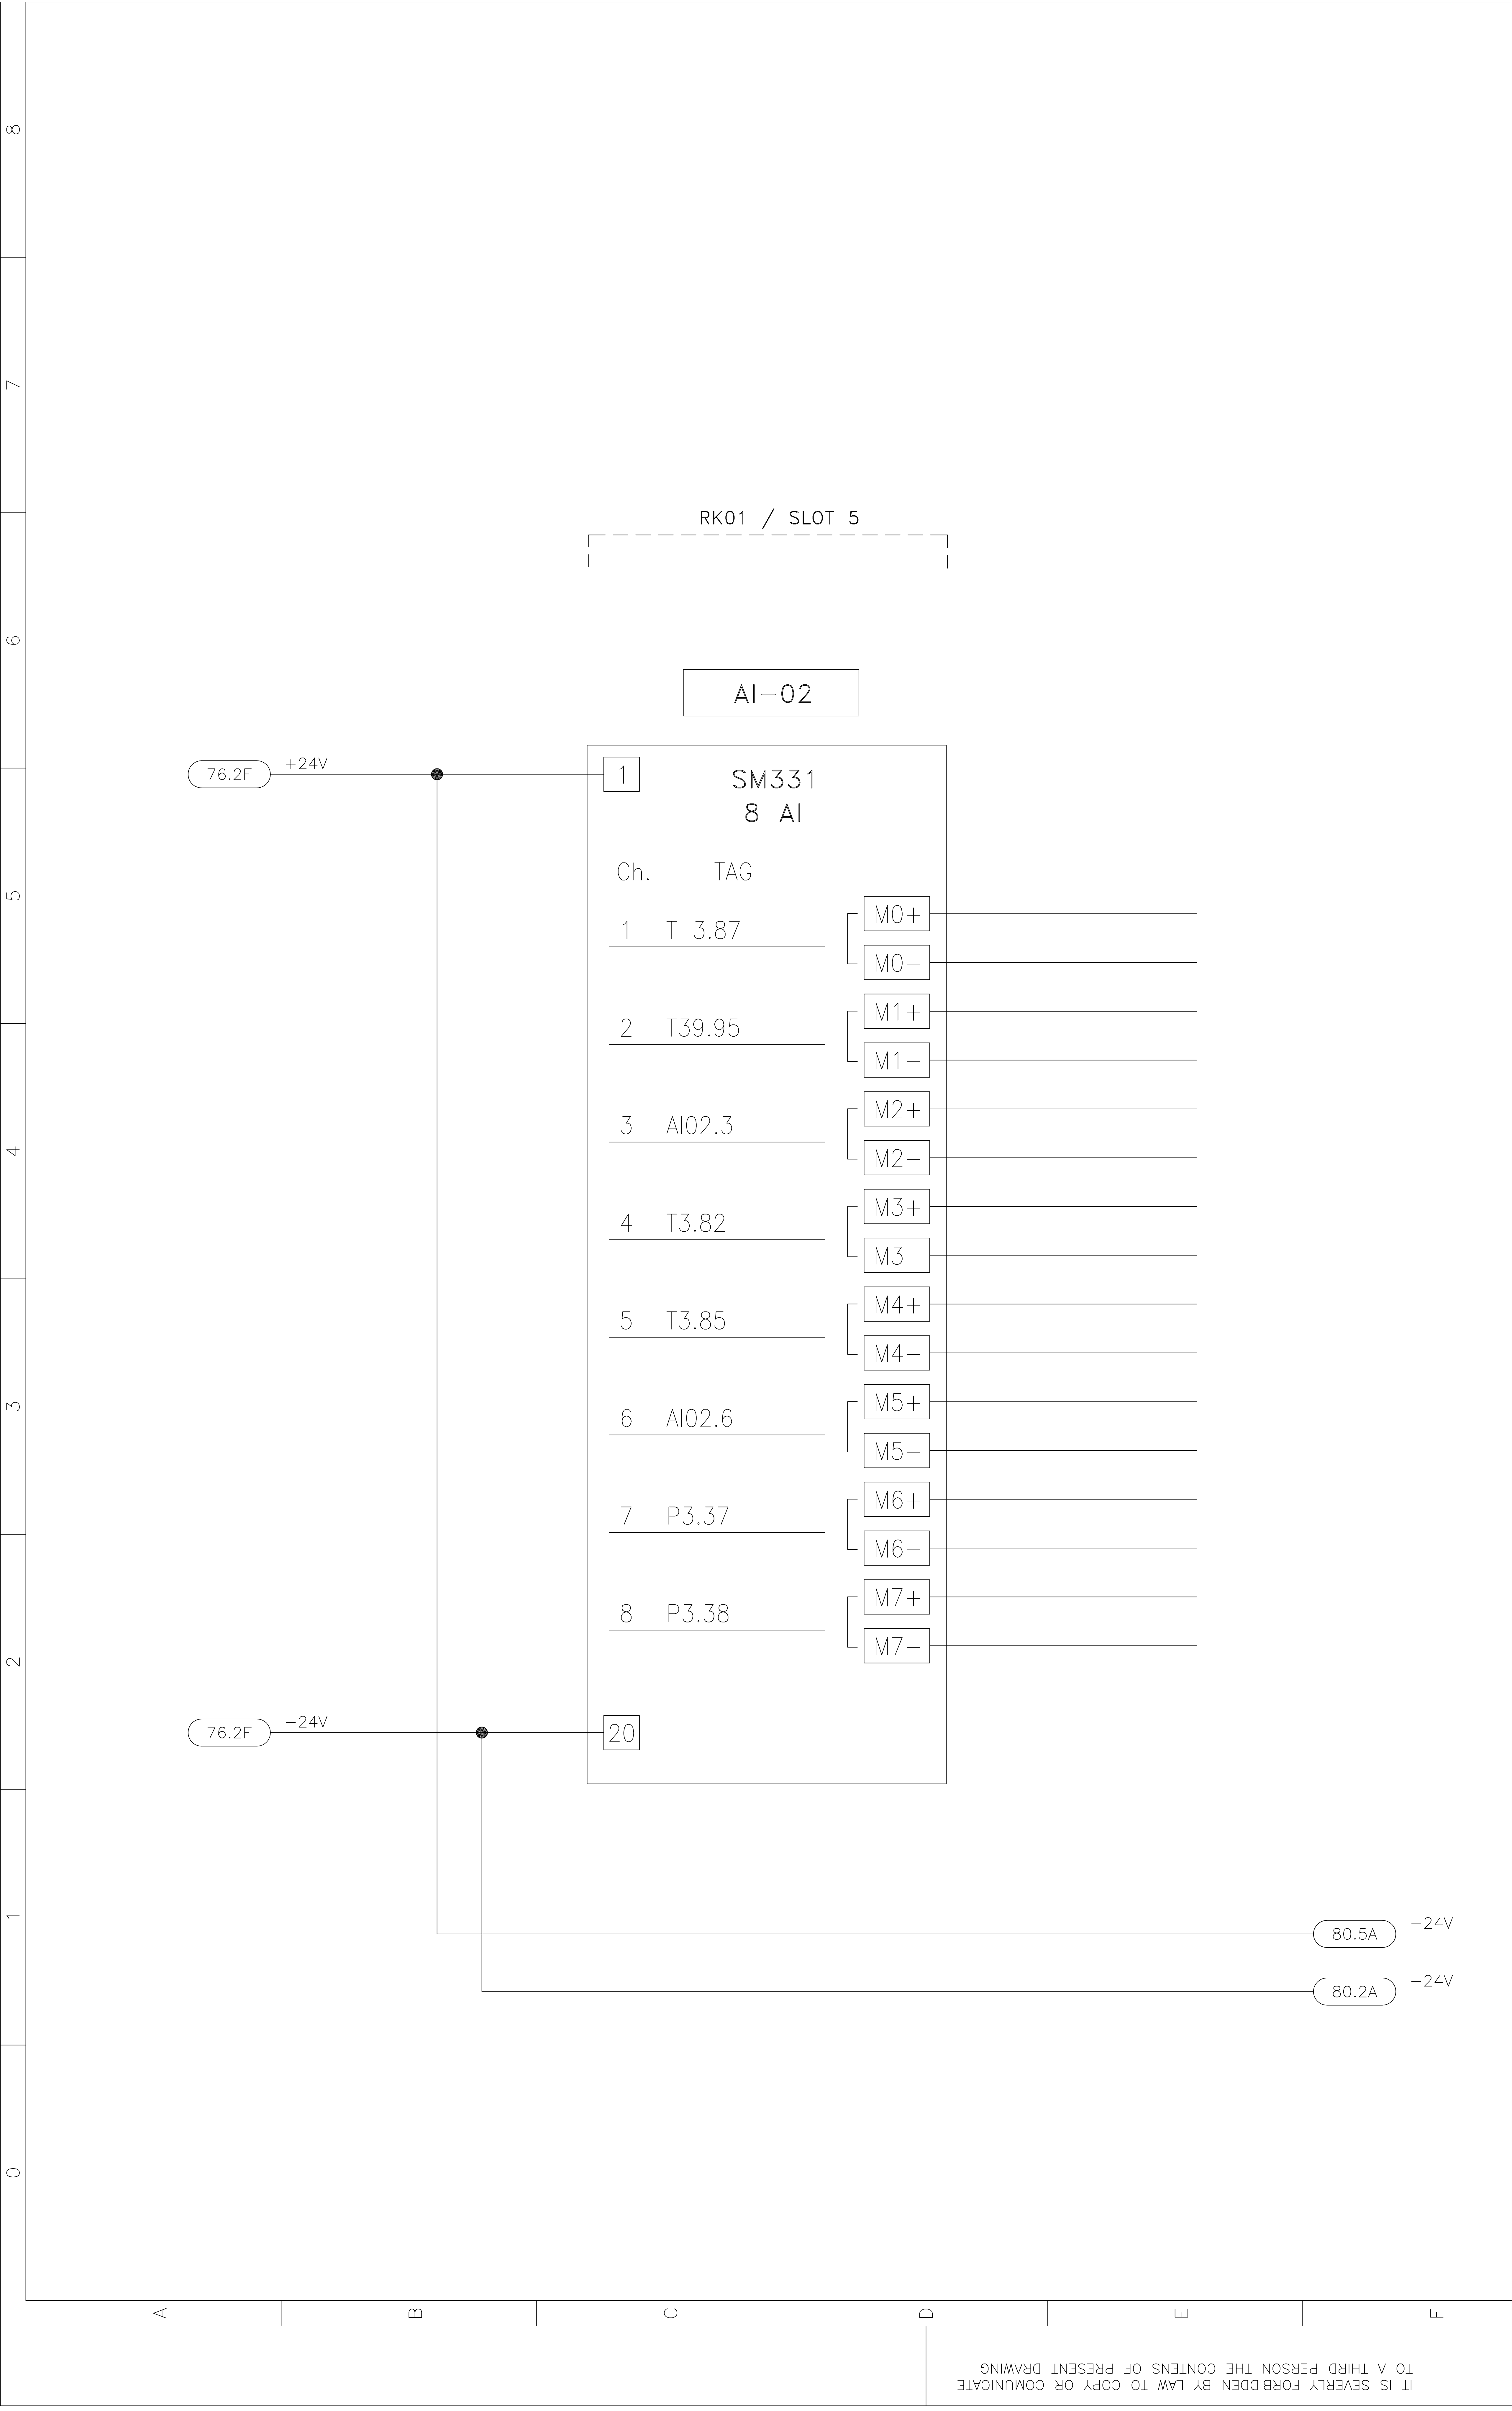


PLANT LOCATION		ASCC ALEXANDRIA		JOB		ID7854	
SECTION		AI02 – ANALOG INPUT WIRING DIAGRAM		DWG N.		ASCC_MRZ-2102	
DOC. TYPE		MAERZ – CABINET LAYOUT		FILE NAME		ASCC_MRZ-2102-078	
NOTE		ASBUILT		DATE		REV	PREV
				30/5/2006		00	76
						PAGE	NEX
						78	80


CLIENT


ASCC



ASCC ALEXANDRIA

ID7854

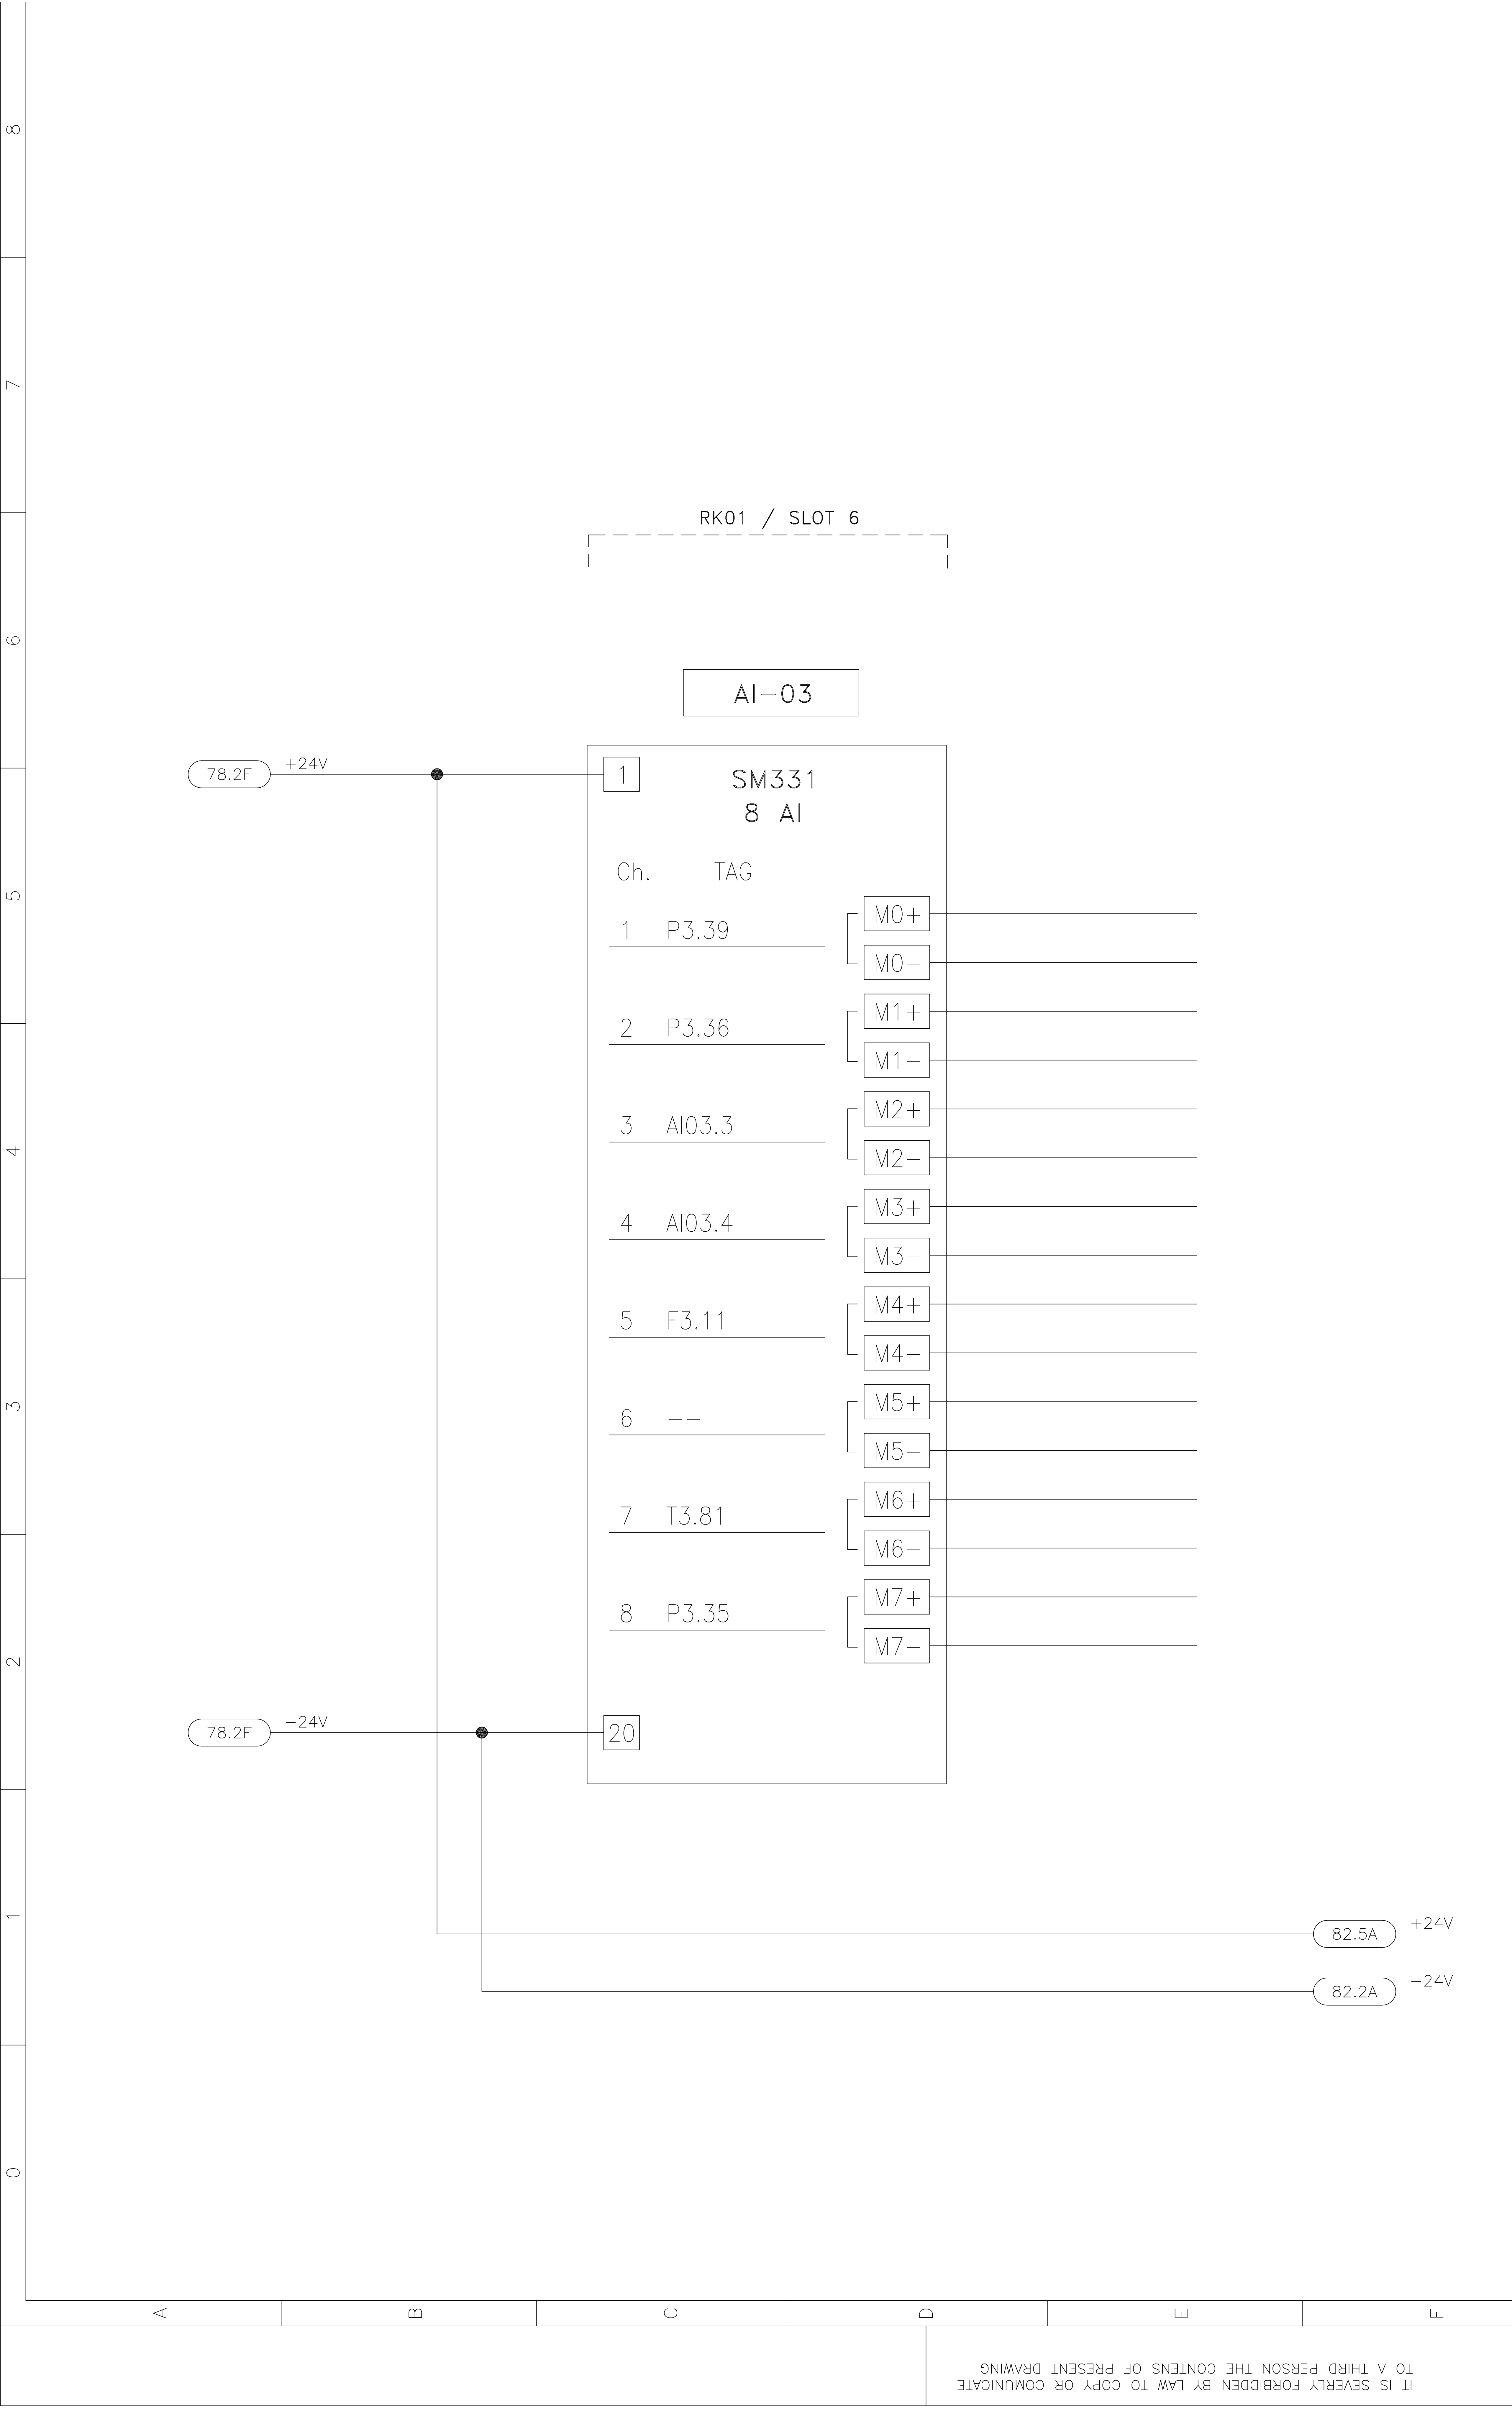

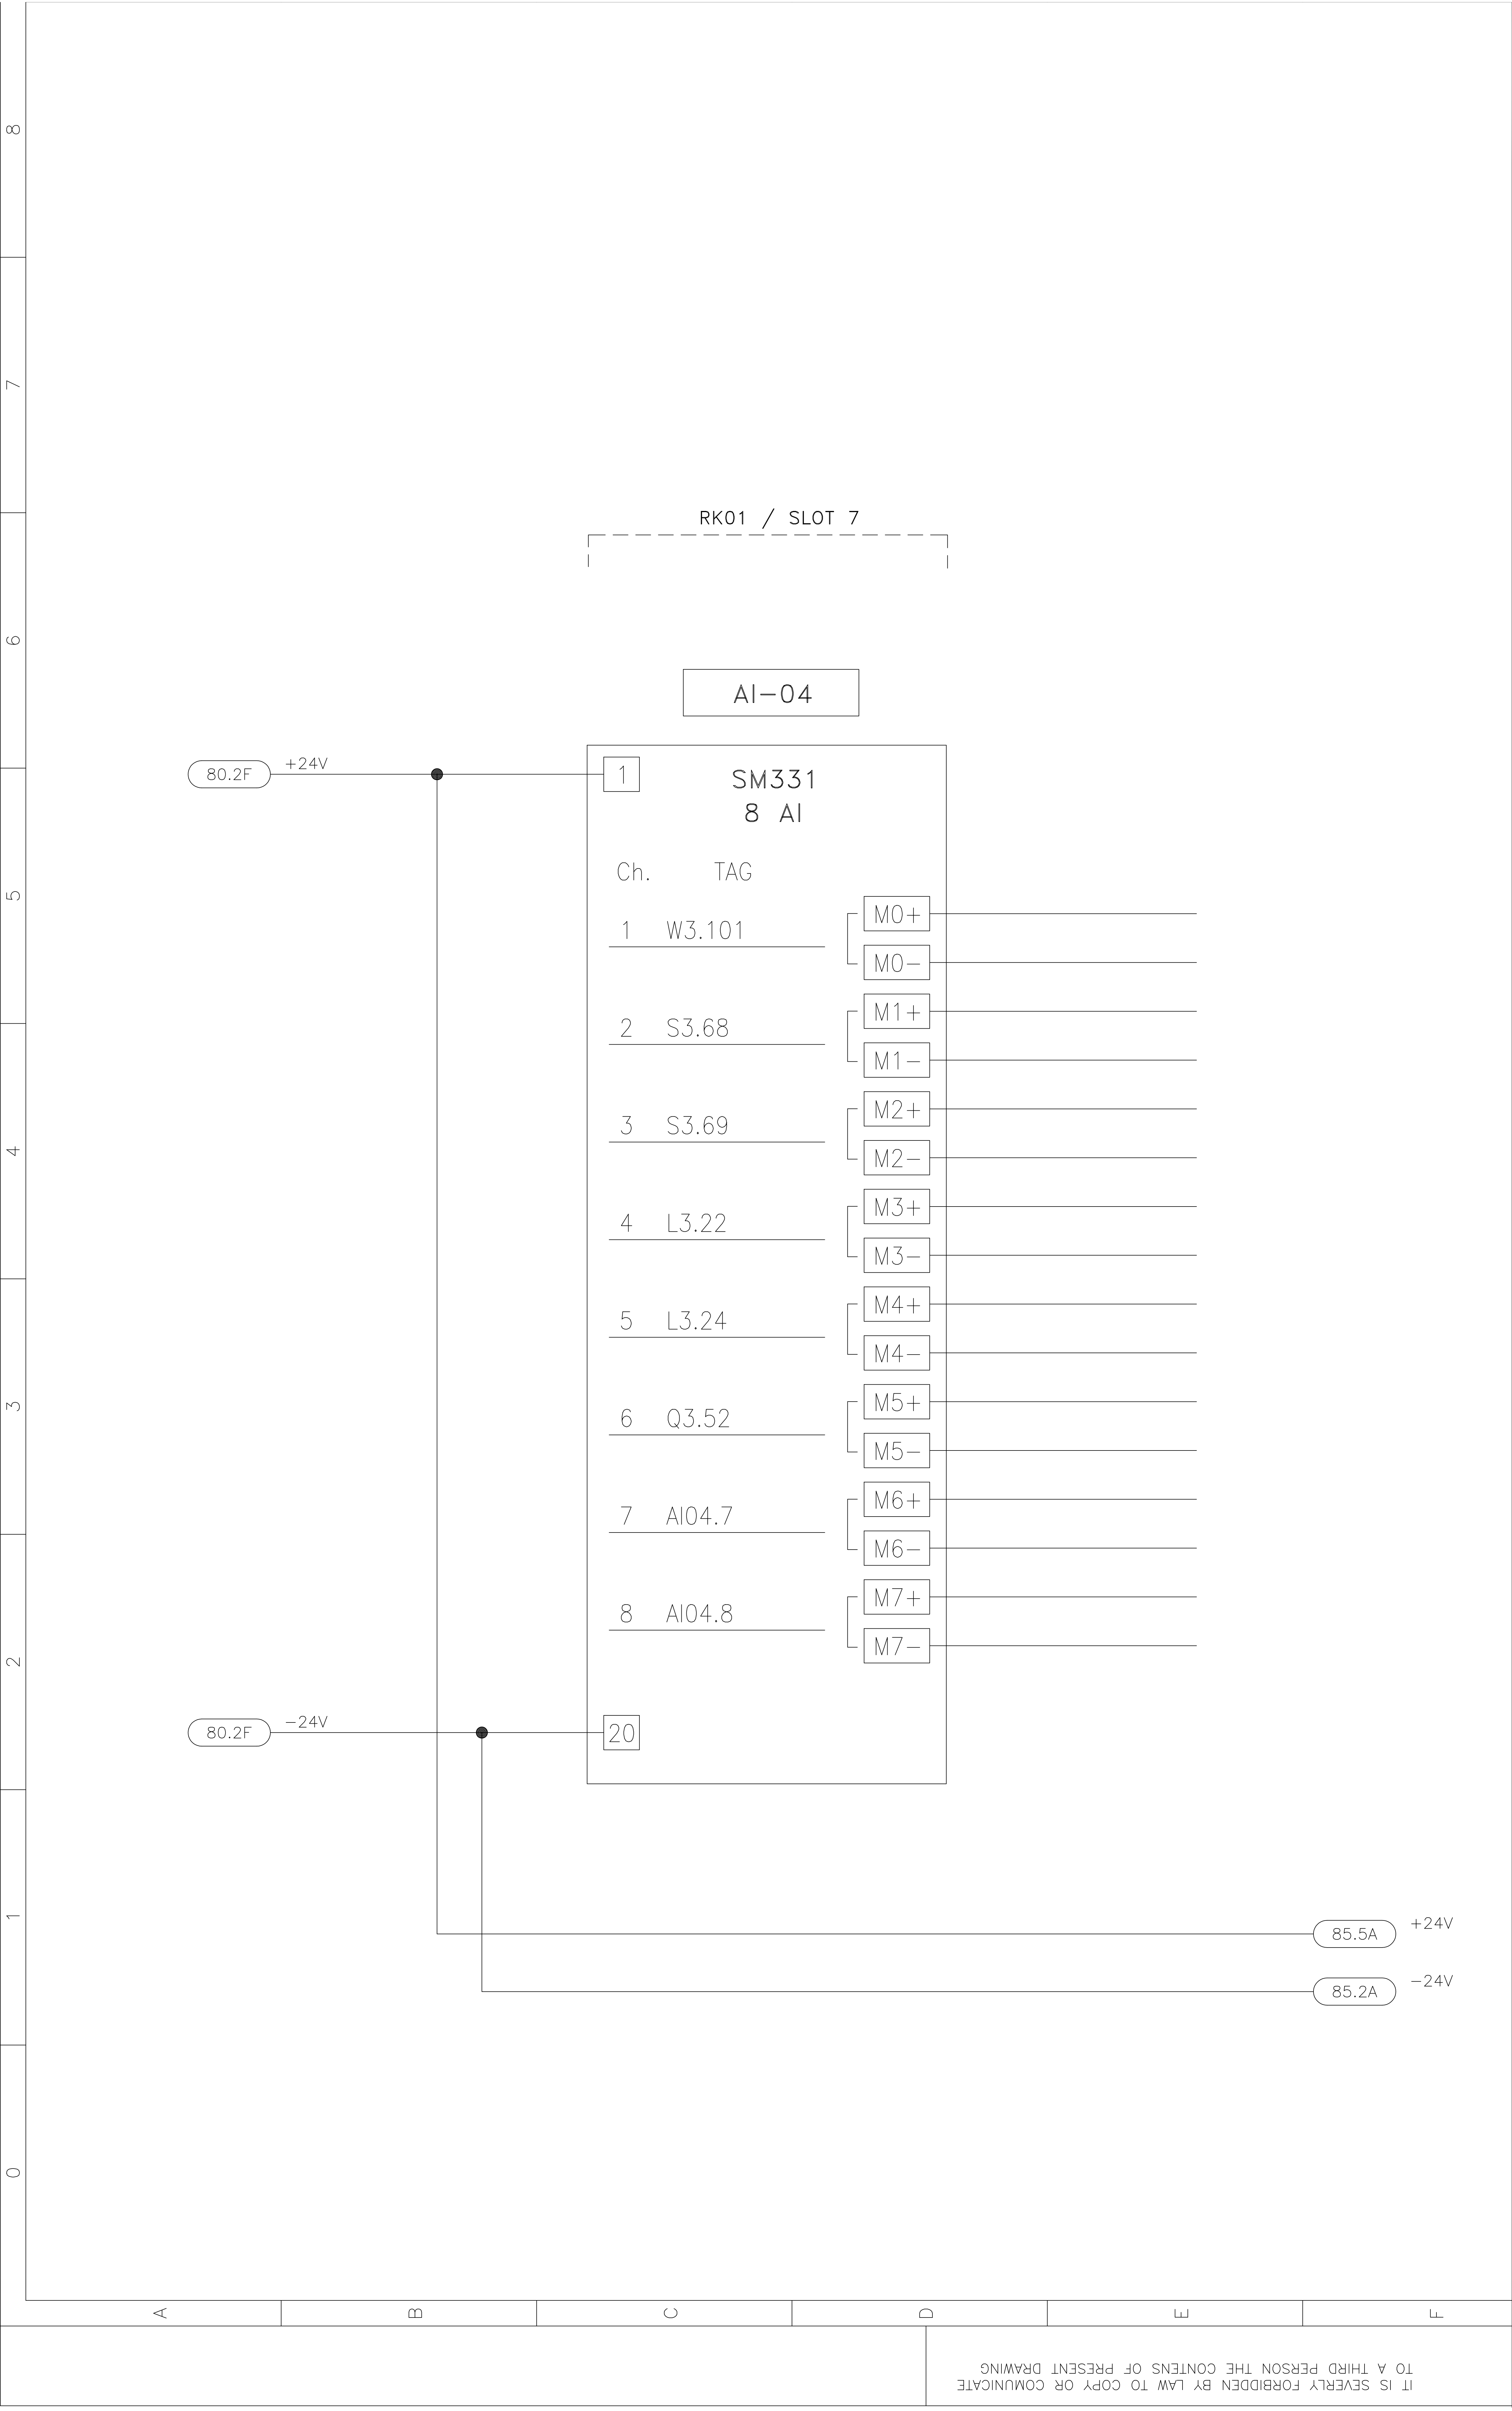

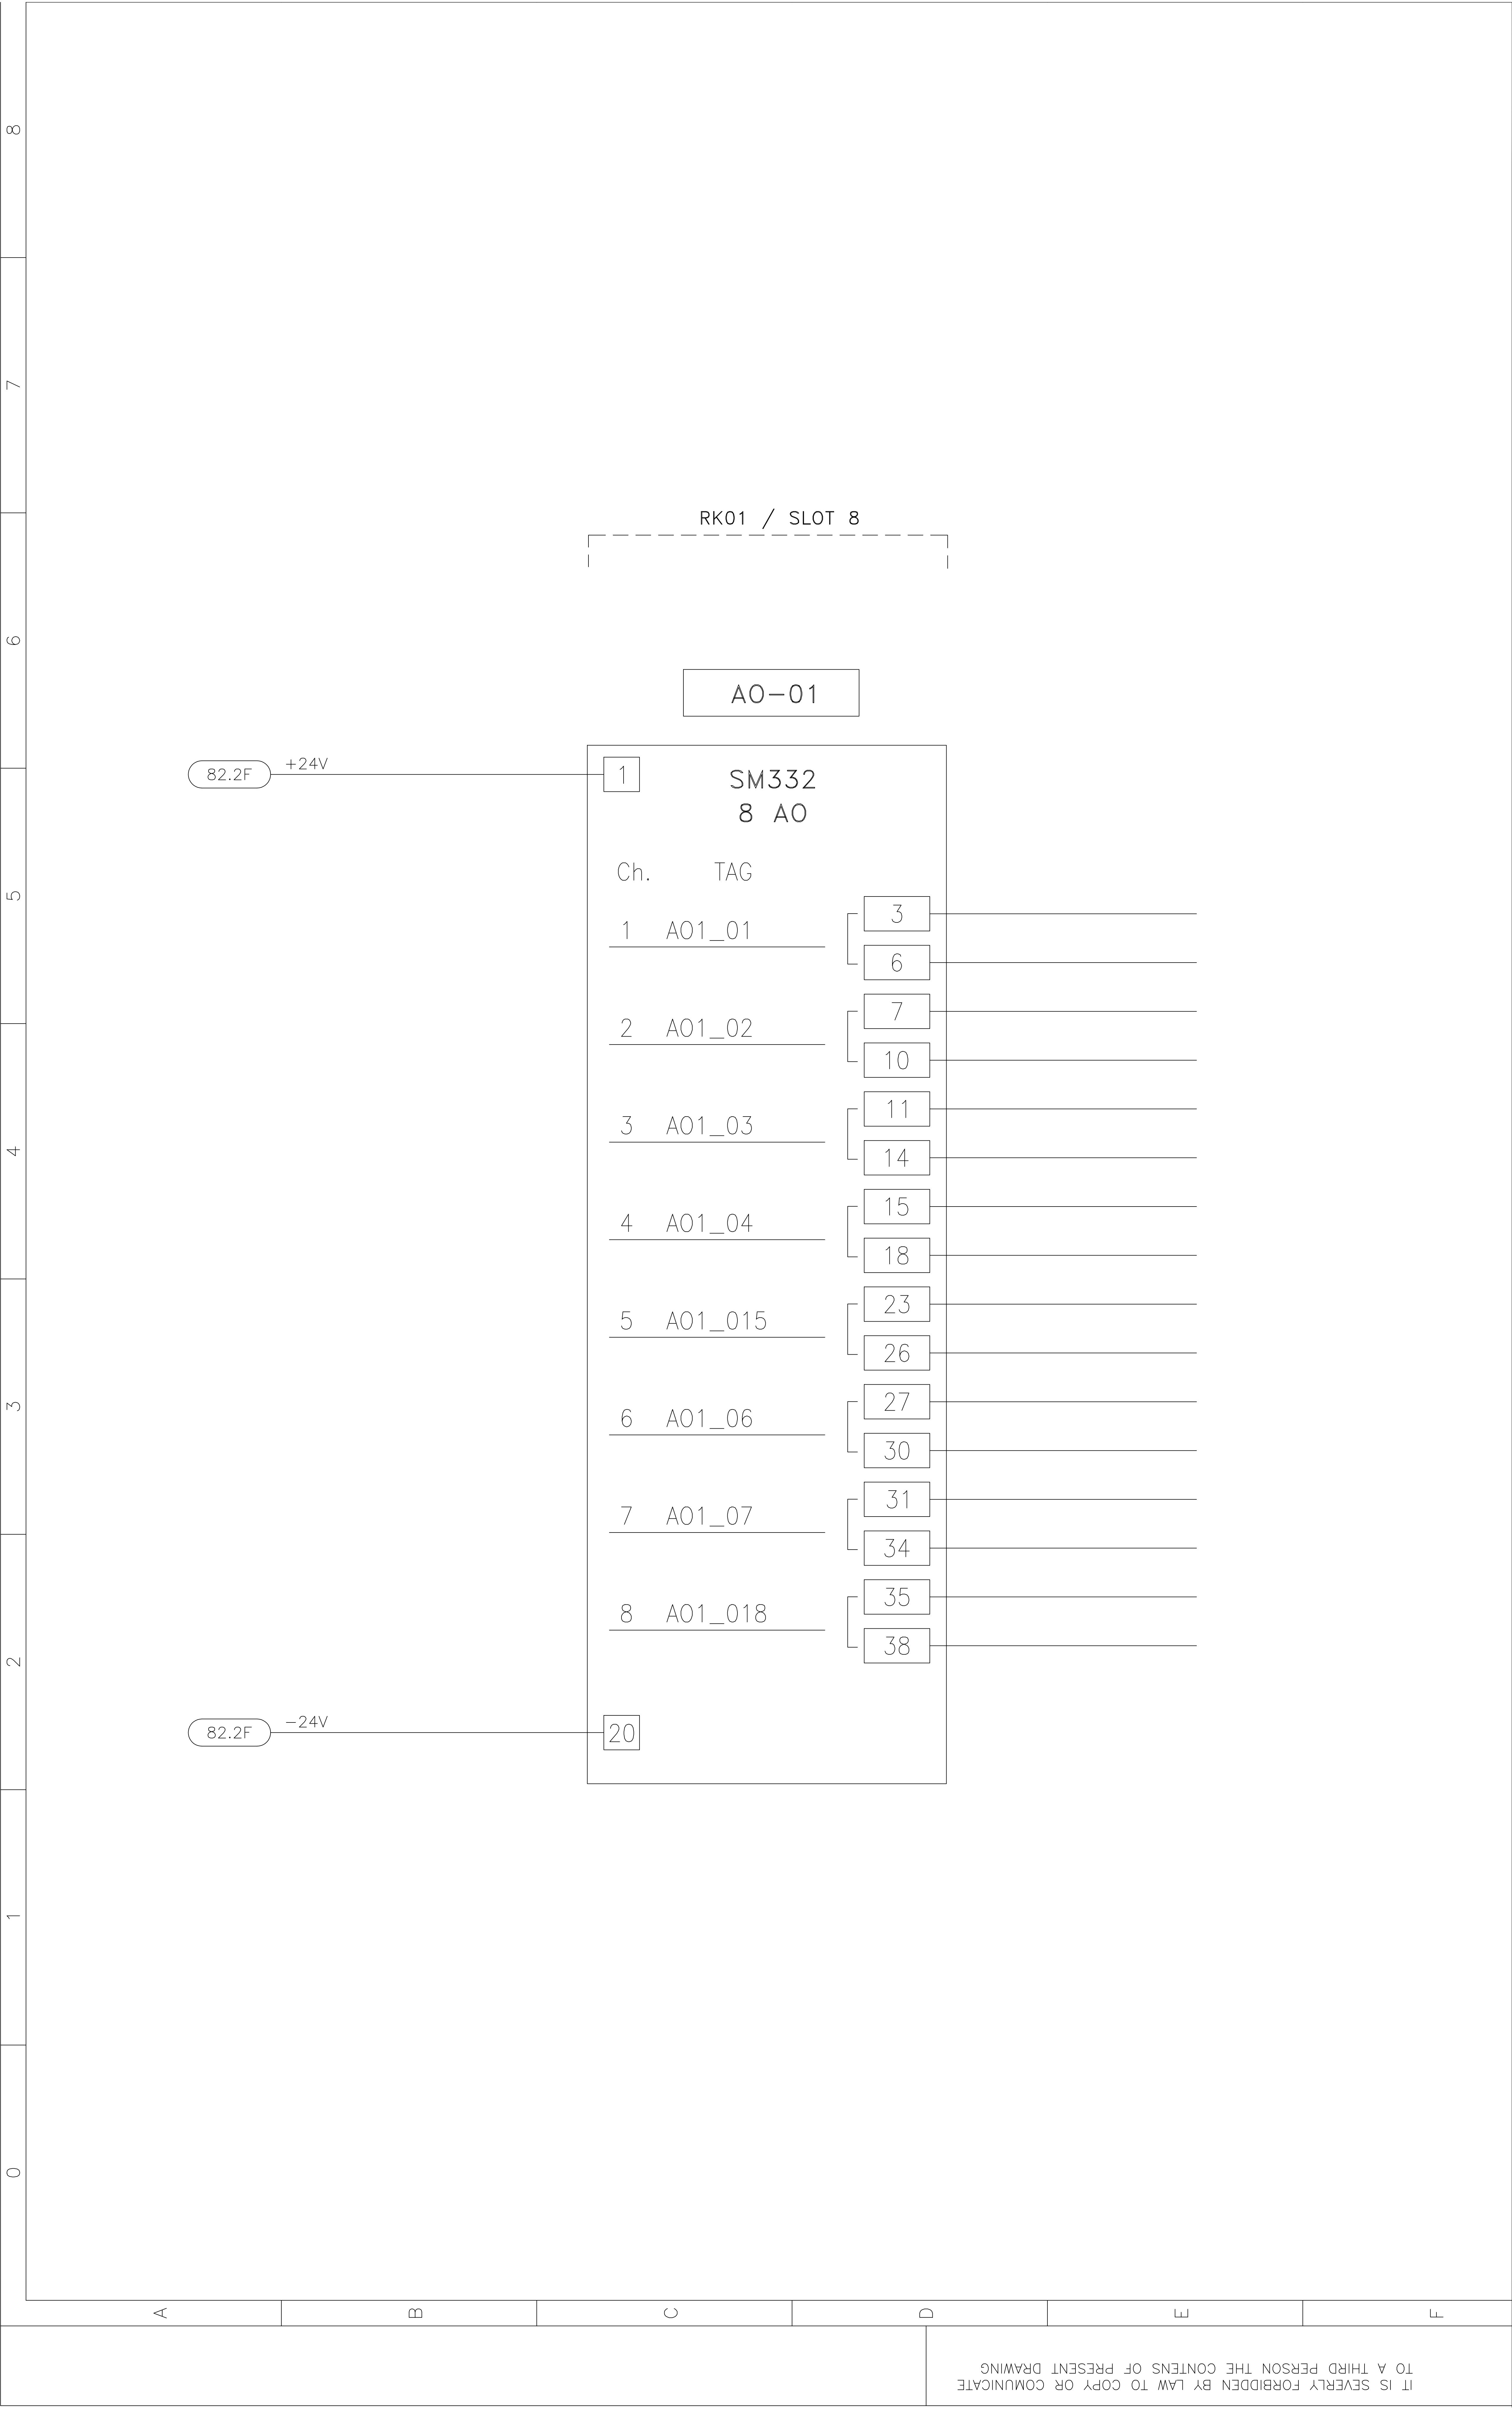
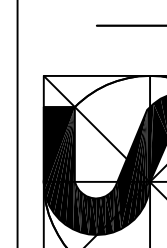
<div><div></div><div></div></div>		PLANT LOCATION		ASCC ALEXANDRIA		CLIENT				
NOTE		ASBUILT		SECTION		A001 – ANALOG OUTPUT WIRING DIAGRAM				
				DOC. TYPE		MAERZ – CABINET LAYOUT				
						ASCC				
						JOB		ID7854		
						DWG N.		ASCC_MRZ-2102		
						FILE NAME		ASCC_MRZ-2102-085		
						DATE		REV	PAGE	NEXT
						30/5/2006		00	82	85
										/